

FRASER COAST REGIONAL COUNCIL

BOORAL ROAD 1632

CH. 4.640km - 4.950km

WOODS ROAD INTERSECTION UPGRADE



JOB SITE

228/1632/1075873

CHGE: 4.640-4.950km

The works shown on this drawing are a factual representation of the works constructed.	
Signature	NR
Name	Gakul Gurung (RPEQ 18777)
Title	Engineer (Civil)

Date 26/02/2020

DRAWING INDEX

DRAWING NUMBER	REVISION	DESCRIPTION
824422	B	LOCALITY PLAN AND DRAWING INDEX
824423	B	CONTROL LINE SETOUT
824424	B	ROAD TYPICAL SECTIONS AND DETAILS
824425	B	PAVEMENT DETAILS
824426	B	TURNOUT GENERAL ARRANGEMENT AND SETOUT
824427	B	SIGNS AND PAVEMENT MARKING LAYOUT
824428	B	ANNOTATED ROAD CROSS SECTIONS MC00 SHEET 1 OF 6
824429	B	ANNOTATED ROAD CROSS SECTIONS MC00 SHEET 2 OF 6
824430	B	ANNOTATED ROAD CROSS SECTIONS MC00 SHEET 3 OF 6
824431	B	ANNOTATED ROAD CROSS SECTIONS MC00 SHEET 4 OF 6
824432	B	ANNOTATED ROAD CROSS SECTIONS MC00 SHEET 5 OF 6
824433	B	ANNOTATED ROAD CROSS SECTIONS MC00 SHEET 6 OF 6

TOTAL NUMBER OF DRAWINGS = 12

SCHEME SUBMITTED (External Consultants or Internal Business Unit):
This design meets the requirements of all relevant Australian Standards, Austroads Guidelines and Transport and Main Roads – Policies, References, Standards, Planning and Design Instructions, Guidelines and the requirements of the project brief/functional specifications.

SIGNED: MARK MORRIS

TITLE: PRINCIPAL DESIGNER

Organisation: TRANSPORT AND MAIN ROADS

DATE: 05/11/2019

SCHEME SCOPE AND FINANCIAL APPROVAL:

I hereby certify that this scheme complies with the intent of the scope and financial limits of the relevant project on QTRIP and the scheme is approved for release in accordance with that program.



SIGNED: HENDRIK ROUX

TITLE: DISTRICT DIRECTOR WBB

DATE: 06/11/2019



Associated Job Nos	Survey Data	Scales	FRASER COAST REGIONAL COUNCIL				Locality Plan and Drawing Index
	Datum GDA 94		BOORAL ROAD (1632)				
Auxiliary Org Nos	Horiz. Grid MGA 94, Z56	NTS	CTL CHGE	4640 - 4950			
Height Origin	AHD DERIVED		Reference Points				
Survey Books	228109		Preceding RP	Dist. to start of job (km)	From start to end of job	From end to Following RP	
Revisions/Descriptions							
Certification							
Date Microfiled							

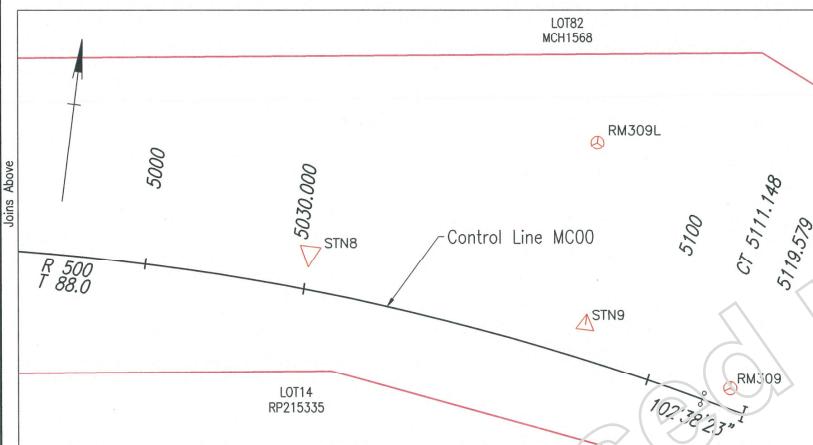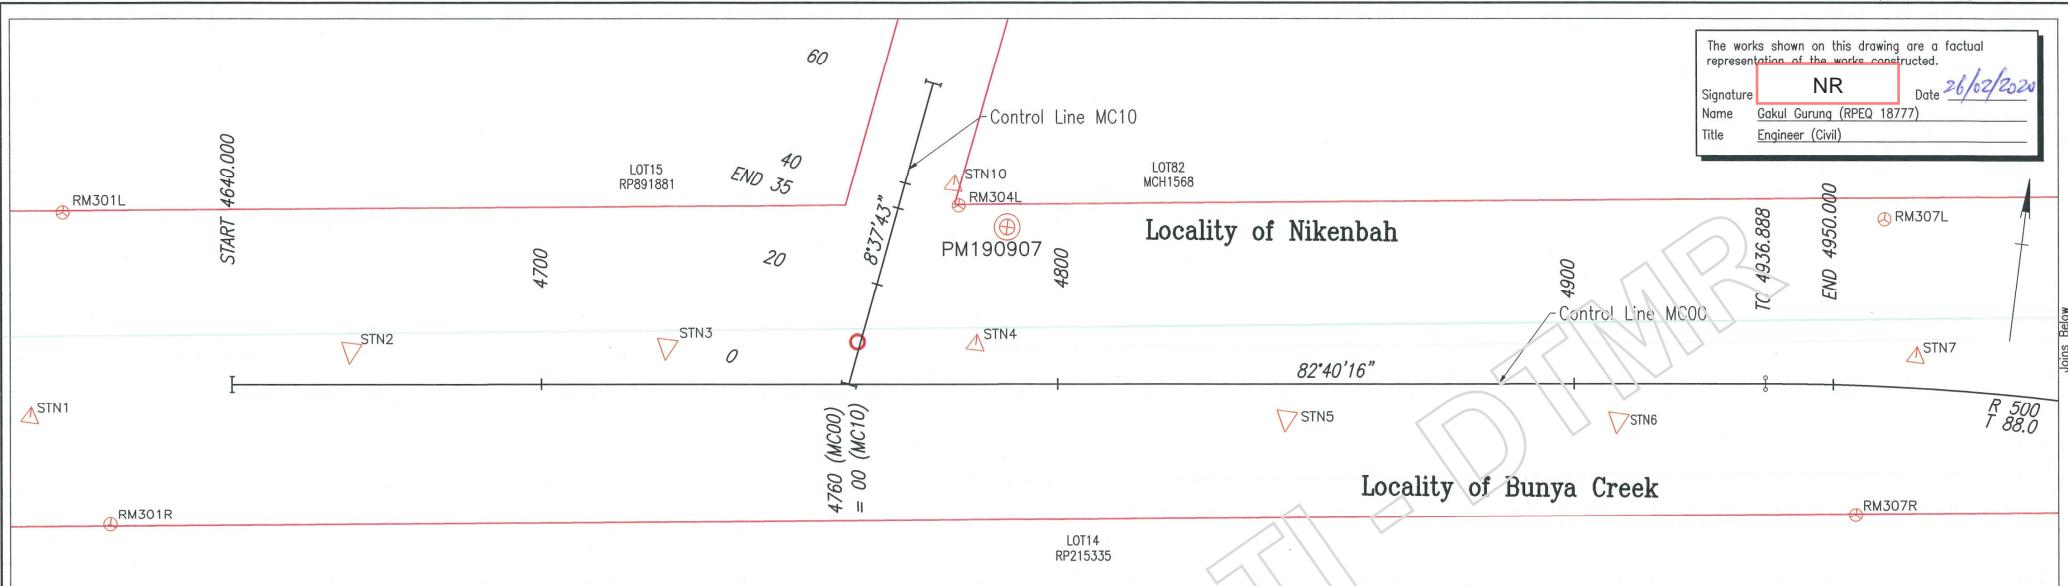

CONTROL LINE MC00				
PT	CHAINAGE	EASTING	NORTHING	BEARING
START	4640.000	481102.998	719267.459	82°40'15.69"
TC	4936.888	481397.461	7197305.331	82°40'15.69"
END	4950.000	481410.484	7197306.820	
R500		481484.764	7197316.560	
CT	5111.148	481570.654	7197297.299	102°38'23.05"
IP 3	5118.579	481578.880	7197295.454	102°38'23.05"

CONTROL LINE MC10				
PT	CHAINAGE	EASTING	NORTHING	BEARING
START	0.000	481221.569	7197282.709	82°37'43.21"
END	35.000	481226.820	7197317.317	82°37'43.21"
IP 2	60.005	481230.571	7197342.034	82°37'43.21"

Permanent Marks					
Name	Easting	Northing	Height	Combined Scale Factor	Comment
PM190907	481248.074	7197316.379	7.146	0.99959591	PM190907 - STAR PICKET

Survey Stations			
Name	Easting	Northing	Combined Scale Factor
STN1	481065.118	7197256.100	0.99959594
STN2	481124.984	7197276.677	0.99959593
STN3	481185.631	7197285.199	0.99959593
STN4	481244.890	7197293.291	0.99959589
STN5	481306.400	7197286.636	0.99959586
STN6	481370.138	7197294.425	0.99959582
STN7	481425.680	7197314.027	0.99959564
STN8	481491.689	7197315.321	0.99959539
STN9	481546.477	7197308.659	0.99959545
STN10	481236.840	7197323.043	0.99959594

Offset Stations			
Name	Easting	Northing	Combined Scale Factor
RM301R	481083.114	7197237.643	0.99959595
RM301L	481066.445	7197295.949	0.99959600
RM304L	481238.262	7197319.269	0.99959594
RM307L	481416.322	7197339.434	0.99959581
RM307R	481417.982	7197282.356	0.99959563
RM309L	481544.423	7197343.662	0.99959575
RM309	481575.807	7197300.007	0.99959545

G				Associated Job Nos	Survey Data		Scales 0 5 10 15 20m	FRASER COAST REGIONAL COUNCIL			CONTROL LINE SETOUT			
F				Datum	GDA 94			BOORAL ROAD (1632)						
E				Auxiliary Drg Nos	Horiz. Grid	MGA 94, Z56		CTL CHGE 4640 - 4950						
D				Height Origin	AHD DERIVED			Reference Points						
C				Survey Books	228109	Dimensions shown in metres except where shown otherwise	Preceding RP	Dist. to start of job (km)	From start to end of job	From end to Following RP	Following RP			
B	As Constructed													
A	Issued For Construction													
	Revisions/Descriptions	Certification	Date	Microfiled										

Last Modified: Feb 25, 2020 - 12:39pm XREFS: - X5500.4wq

NR 25/2/2020

CAD FILES G:\BUND\TechServ\Projects\228 Fraser Coast\228 1632 107583 Woods Rd SRS\Design\ACAD\324423 CS_AscOn.dwg

Associated Job Nos

Survey Data

Datum: GDA 94

Auxiliary Drg Nos: 824422 - 824433

Horiz. Grid: MGA 94, Z56

Height Origin: AHD DERIVED

Survey Books: 228109

Dimensions shown in metres except where shown otherwise

FRASER COAST REGIONAL COUNCIL

BOORAL ROAD (1632)

CTL CHGE 4640 - 4950

Reference Points

Preceding RP Dist. to start of job (km) From start to end of job From end to Following RP Following RP

1A 4.64 .31 4.969 2

Through Chainage from INT 163/1632/164, 4.64 - 4.95km

Engineering Certification (RPEQ)

Drawn by D. Riemer

Designed by D. Riemer

Signature: NR Date: 26/02/2020

Name: Gakul Gurung (RPEQ 18777)
Title: Engineer (Civil)

Queensland Government

Job No.: 228/1632/1075873
Contract. No.: CN-13066
Drawing No.: 824423
Series Number: 02 of 12
MRR_Detail (02/14)

TRAFFIC DATA

AADT (2018)	= 5737 VPD
Lane AADT (2018)	= 2800 VPD
% Heavy Vehicles	= 5.8%
Growth	= 5.5%

The works shown on this drawing are a factual representation of the works constructed.

Signature **NR** Date **26/02/2020**
Name **Gakul Gurung (RPEQ 18777)**
Title **Engineer (Civil)**

Information shown on Type Cross Sections is nominal only. Refer Setting Out Drawings & Annotated Cross Sections for variations.


Road Surfacing

Primer Seal (C170, 2% cutter) - 0.9 L/m²
[Widening Only] - 10 mm @ 150 m²/m³


Seal (S35E) - 1.9 L/m²
[Full Width] - 14 mm @ 100 m²/m³

Scatter Coat
[Intersection] - 7 mm @ 450 m²/m³


Seal design to be confirmed by Administrator prior to sealing

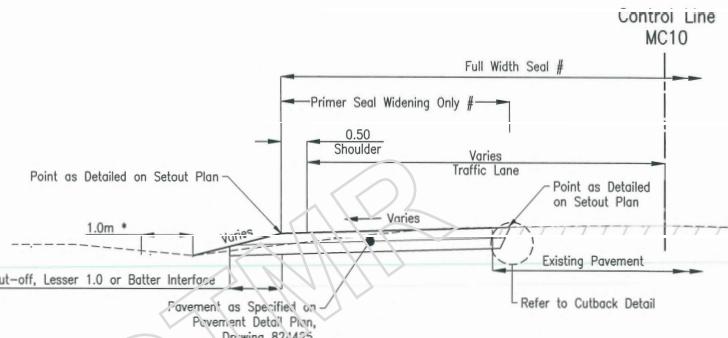**TYPE C - WIDENING - KERB RETURN**

(MC10) LHS & RHS

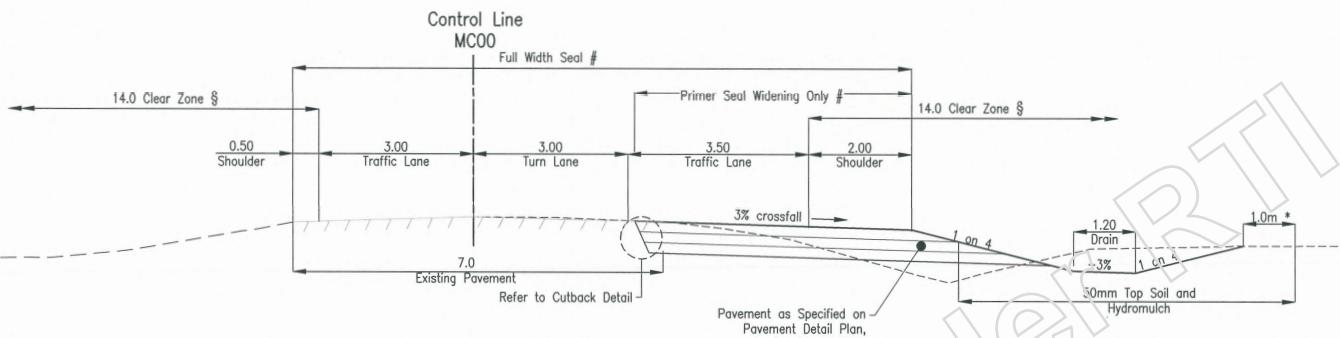
**TYPE B - WIDENING - CHR(s)**

CHGE: 4738 - 4950 (MC00)

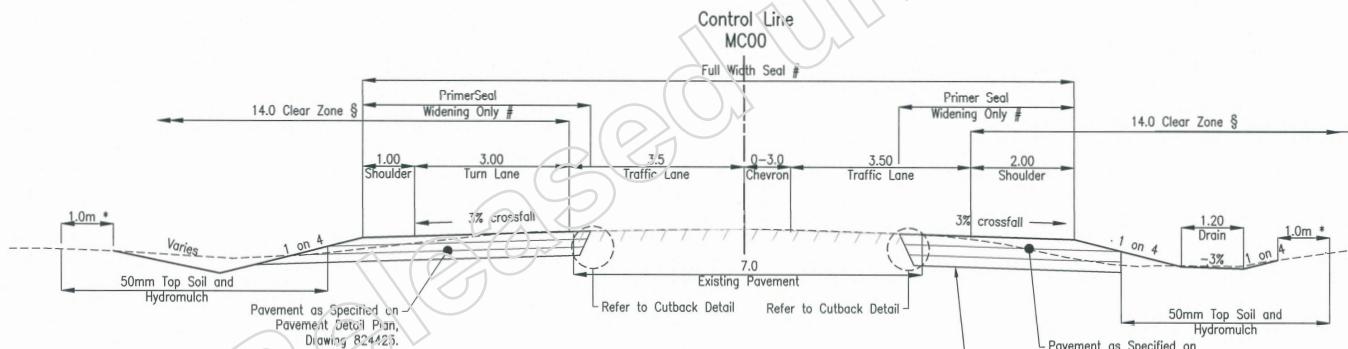**TYPE A - WIDENING - AUL(s)**

CHGE: 4640 - 4738 (MC00)

§ Clear zone based on 110km/h
design speed and batter slope 1:4.
* Offset for Clearing & Grubbing.

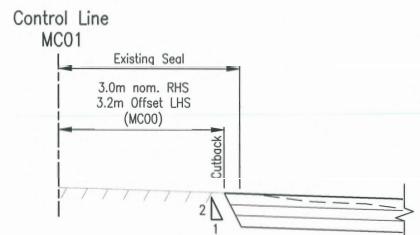**CUTBACK DETAIL**4C New 375 RCP (7.32m)
Sloping Headwalls

4B Ex. 900 RCP (11.12m) 4883
Extend 4.88 RHS (2/2.44) (Class 3, Butt Joint) (4.84 outside of walls)
Skew Angle 4.5° Skew Number 94.5 (16.00 overall length)
Cast Inslu Endwall with Apron and Cutoff Wall RHS
Reinforced Wingwall (W1 3.2, W2 2.8) (R)Conc. 2.3m3
Reinforced Conc. Apron Conc. 0.5m3, C/O Wall Conc. 0.2m3
Backfill Material 0.8m3
Bedding/Haunch Material 2.6m3 (H2)
Standard Drawings - 1304, 1359
External Dia. 1029mm, Pipe thick. 57mm, Headwall Ht. 250mm


4A Ex. 4/450 RCP (14.80m) 4634
To Remain

DRAINAGE DETAILS


G	F	E	D	C	B As Constructed	Associated Job Nos	Survey Data		Scales	FRASER COAST REGIONAL COUNCIL					ROAD TYPICAL SECTIONS AND DETAILS					Queensland Government	
							Datum	GDA 94		BOORAL ROAD (1632)					Engineering Certification (RPEQ)						
					Auxiliary Drg Nos	Horiz. Grid	MGA 94, Z56		NTS	CTL CHGE	4640 - 4950				Drawn	Engineering Certification (RPEQ)					Job No. 228/1632/1075873
B					Height Origin	AHD DERIVED	Survey Books	228109		Reference Points	Preceding RP	Dist. to start of job (km)	From start to end of job	From end to Following RP	Following RP	ENG. AREA	NAME	SIGNATURE	NR	DATE	
											1A	4.64	.31	4.969	2	CIVIL	Vince Green	Vince Green	10577	05/11/19	Contract. No. CN-13066
															Designed						Drawing No. 824424 IB
															Drawn						Series Number 03 of 12
																					MRR_Detg (02/14)
Last Modified Feb 25, 2020 12:34pm ABTS																					
CAD FILES C:\BUND\TechServ\Projects\228 Fraser Coast\228 1632 1075873 Woods Rd SRS\Design\ACAD\824424_TC_AcCon.dwg																					

The works shown on this drawing are a factual representation of the works constructed.

Signal Name	NR	Date	26/02/2020
Title	Engineer (Civil)		8777

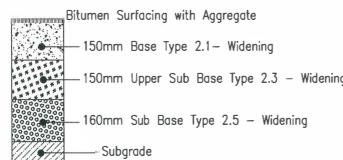


Refer Drawing No 824424 for Typical Road Sections and Details.

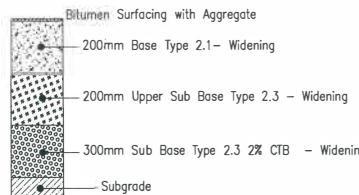

PAVEMENT 1

CHGE: 4640 - 4738 (MC00) LHS
Woods Road Western Kerb
Return and Tapers

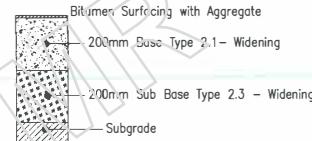

PAVEMENT 2

CHGE: 4640 - 4950 (MC00) RHS

LEGEND

	Pavement 1
	Pavement 2
	Pavement 3
	Scatter Coat


PAVEMENT 3


Woods Road Eastern Kerb Return and Tapers

PAVEMENT DESIGN

Design Life	= 10 years
ESA/day	= 400
DESA	= 2.0×10^{-6}
Design Subgrade	= CBR 3
Design Subgrade	= CBR 1.5 @ 800mm

Pavement design has been based on assumptions from Geotechnical Investigation and site observations and historic data.

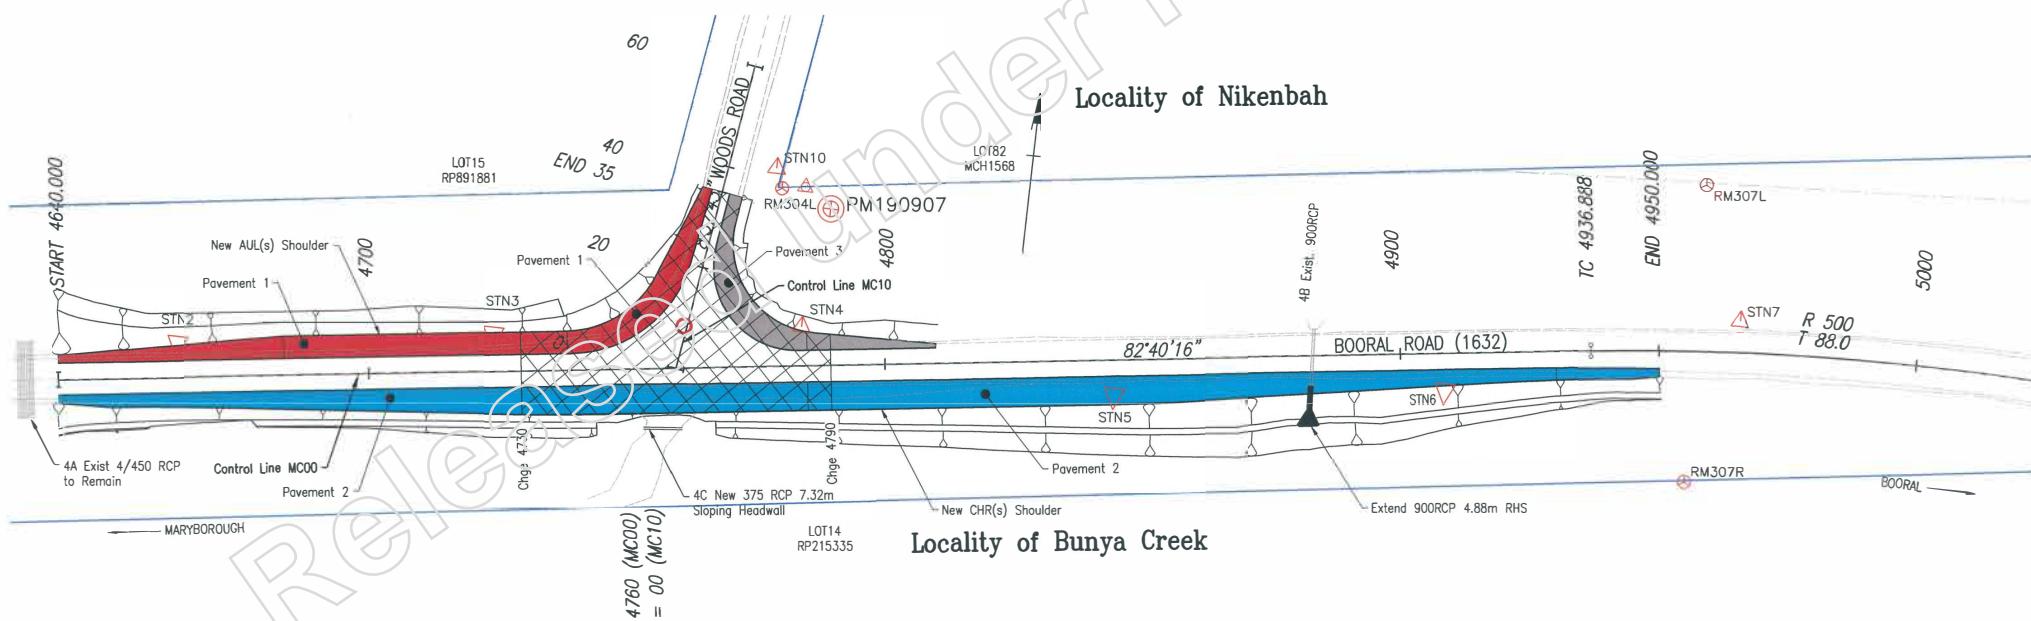

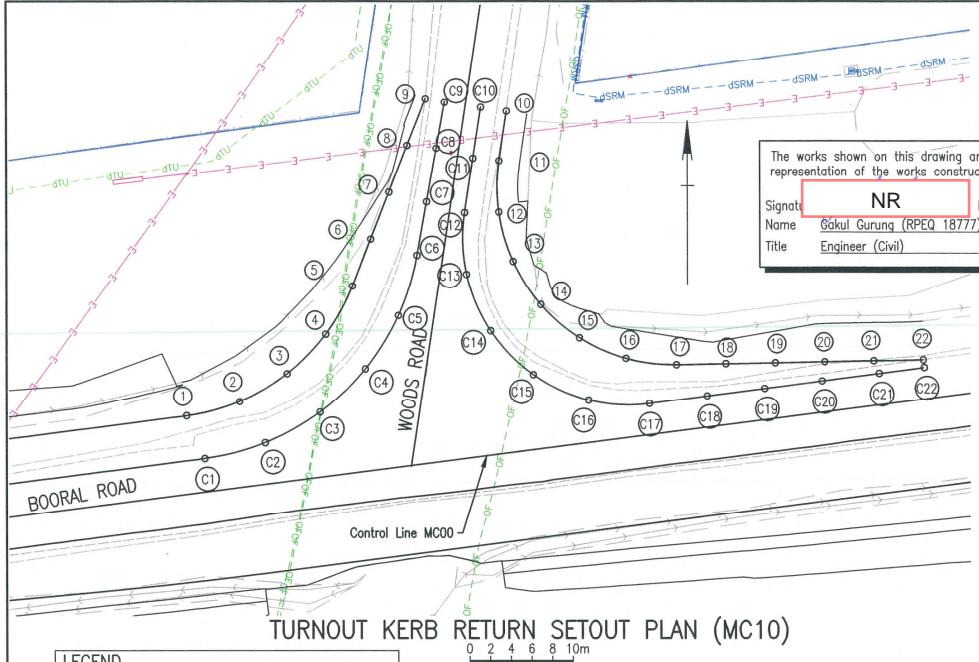

The works shown on this drawing are a factual representation of the works constructed.

Signature: **NR** Date: **26/02/2020**
Name: **Gakul Gurung (RPEQ 18777)**
Title: **Engineer (Civil)**

Grubbing Setout Table


Point	Easting	Northing
G01	481100.939	7197285.721
G02	481118.571	7197282.814
G03	481170.328	7197289.957
G04	481188.566	7197291.373
G05	481197.367	7197294.473
G06	481204.446	7197294.452
G07	481213.748	7197303.387
G08	481218.485	7197310.477
G09	481221.072	7197318.574
G10	481233.762	7197316.425
G11	481234.544	7197303.375
G12	481241.670	7197296.882
G13	481250.506	7197295.537
G14	481260.720	7197297.328
G15	481271.032	7197297.582
G16	481104.622	7197255.877
G17	481121.235	7197258.981
G18	481154.957	7197262.341
G19	481186.986	7197264.690
G20	481203.003	7197266.258
G21	481207.962	7197267.405
G22	481230.540	7197269.357
G23	481235.172	7197269.704
G24	481331.718	7197276.542
G25	481359.810	7197282.404
G26	481403.138	7197295.367
G27	481412.058	7197296.519

Kerb Return Shoulder Setout Table

Points	Eastings	Northings	Heights
1	481199.820	7197287.473	7.378
2	481204.954	7197288.846	7.343
3	481209.546	7197291.522	7.268
4	481213.271	7197295.314	7.151
5	481215.866	7197299.953	7.030
6	481217.641	7197304.440	6.942
7	481219.415	7197308.926	6.873
8	481221.189	7197313.411	6.824
9	481222.963	7197317.896	6.795
10	481230.775	7197316.716	6.868
11	481230.049	7197311.333	6.913
12	481230.022	7197307.016	6.979
13	481231.403	7197302.293	7.067
14	481234.077	7197298.171	7.172
15	481237.820	7197294.983	7.272
16	481242.518	7197292.999	7.359
17	481247.197	7197292.385	7.434
18	481251.984	7197292.481	7.495
19	481256.771	7197292.577	7.544
20	481261.558	7197292.673	7.582
21	481266.344	7197292.768	7.609
22	481271.130	7197292.864	7.624



Kerb Return Cutback Setout Table


Points	Eastings	Northings
C1	481201.579	7197283.364
C2	481207.434	7197284.886
C3	481212.721	7197287.822
C4	481217.107	7197291.987
C5	481220.312	7197297.116
C6	481222.133	7197302.885
C7	481223.063	7197308.011
C8	481223.992	7197313.136
C9	481224.796	7197317.564
C10	481228.285	7197317.100
C11	481227.525	7197312.180
C12	481226.718	7197306.963
C13	481226.907	7197301.068
C14	481229.218	7197295.644
C15	481233.337	7197291.424
C16	481238.705	7197288.984
C17	481244.592	7197288.653
C18	481250.165	7197289.377
C19	481255.737	7197290.101
C20	481261.309	7197290.825
C21	481266.881	7197291.549
C22	481271.227	7197292.114

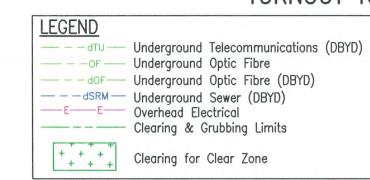

Refer Drawing No 824423 for Control Line Setout and Survey Station Details.

Refer Drawing No 824425 for Pavement Details.

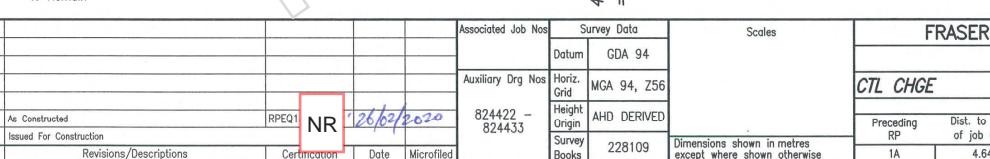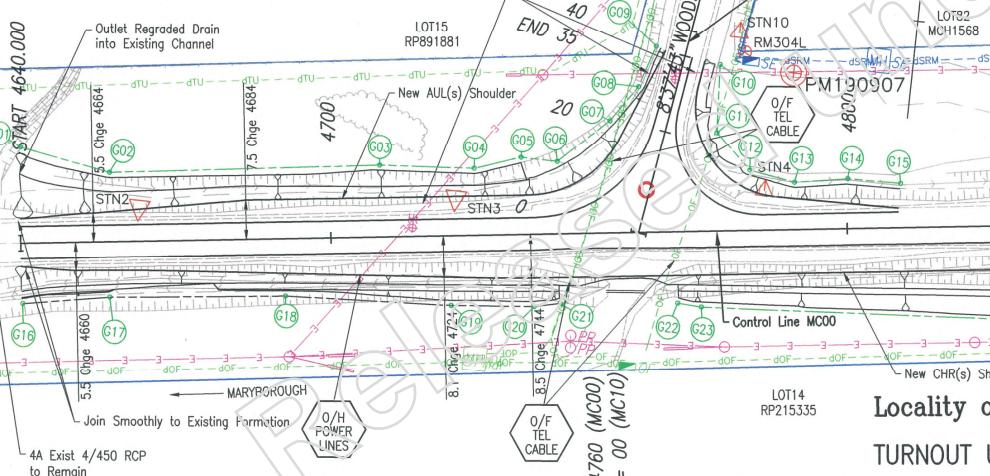

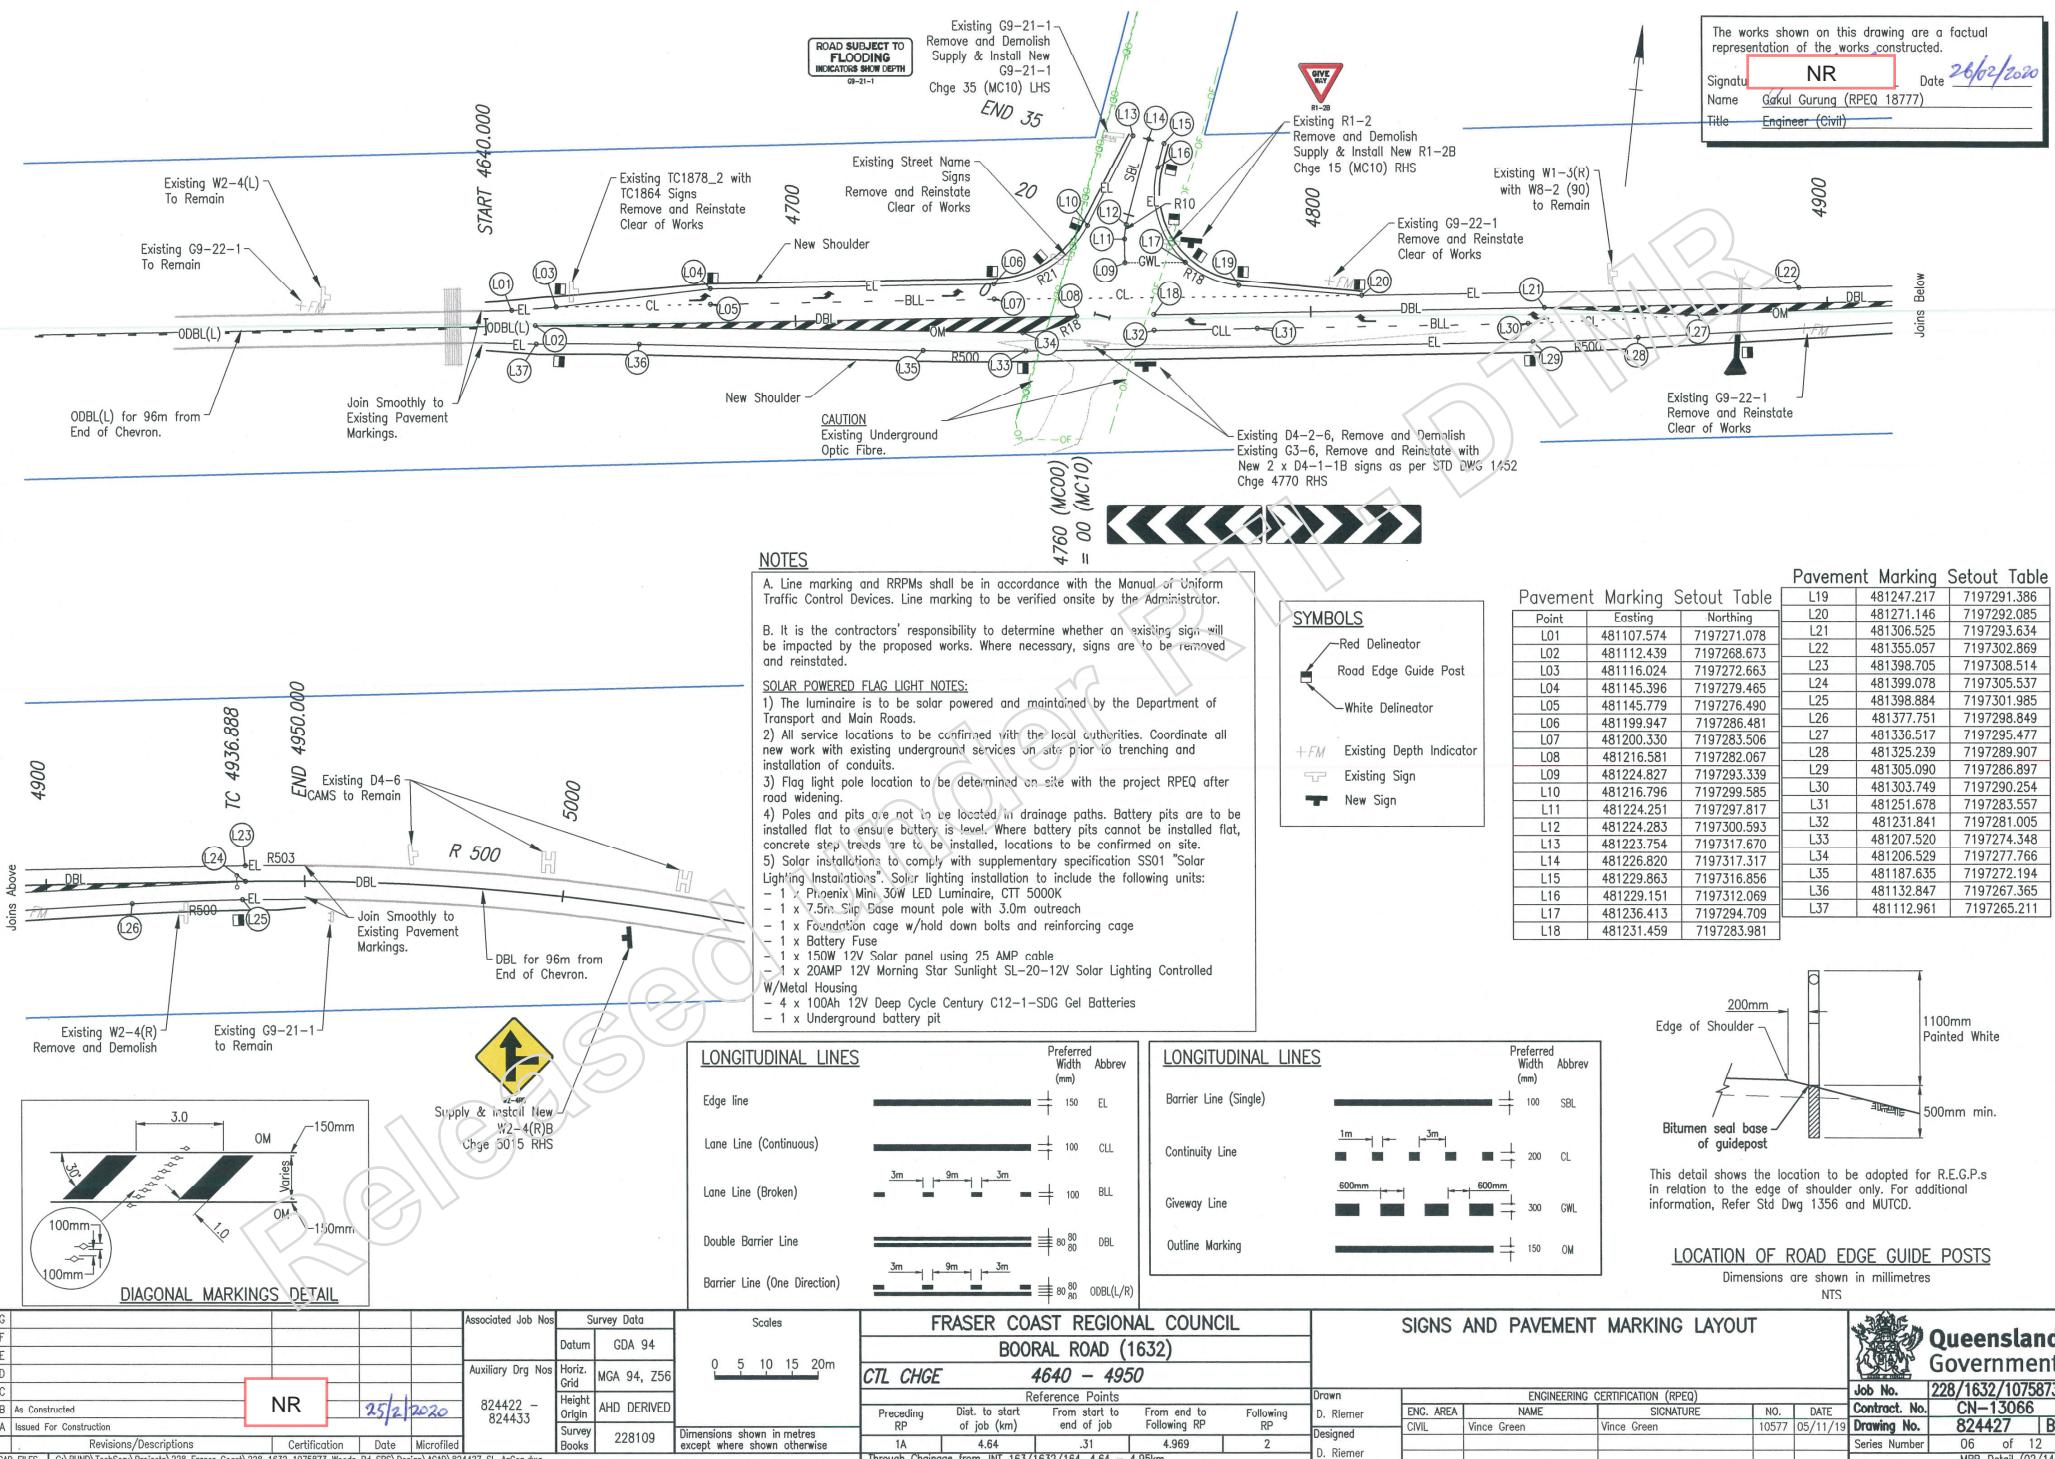

Refer to Type Section & Pavement detail drawings 824424-824425
for As Constructed information

The works shown on this drawing are a factual representation of the works as instructed.		
NR	Date	26/02/2020
Signature	Name	Gokul Gurung (RPEQ 18777)
	Title	Engineer (Civil)

CONTROL LINE MC00
X = 481112.916
Y = 7197268.734
Z = 7.767

Datum 4.00

DESIGN HEIGHT	
SUBGRADE HEIGHT	
EXISTING SURFACE	
OFFSETS	



CONTROL LINE MC00
X = 481102.998
Y = 7197267.459
Z = 7.821

Datum 4.00

DESIGN HEIGHT	
SUBGRADE HEIGHT	
EXISTING SURFACE	
OFFSETS	

CHAINAGE 4640.000

1 in -9.7
1 in -7.8
Off -9.62
Ht. 7.125

1 in -9.7
1 in -7.8
Off -9.62
Ht. 7.125

CHAINAGE 4640.000

CONTROL LINE MC00
X = 481122.835
Y = 7197270.010
Z = 7.714

Datum 4.00

DESIGN HEIGHT	
SUBGRADE HEIGHT	
EXISTING SURFACE	
OFFSETS	

CHAINAGE 4660.000

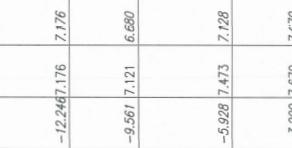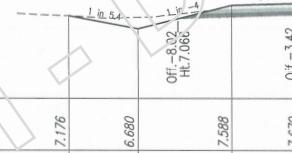


CONTROL LINE MC00
X = 481114.900
Y = 7197268.989
Z = 7.756

Datum 4.00

DESIGN HEIGHT	
SUBGRADE HEIGHT	
EXISTING SURFACE	
OFFSETS	

CHAINAGE 4652.000

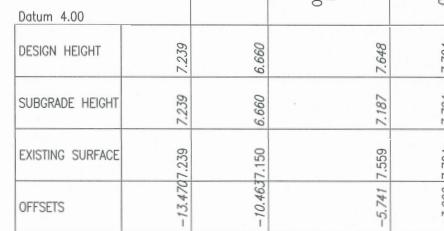

ANNOTATED ROAD CROSS SECTIONS MC00
SHEET 1 OF 6



Queensland Government

Job No. 228/1632/1075873

Contract. No. CN-13066







Drawing No. 824428 1B

Series Number 07 of 12

MRR_Detail (02/14)

The works shown on this drawing are a factual representation of those constructed.
NR
Signature _____ Date 26/02/2020
Name Cakul Gurung (RPEQ 18777)
Title Engineer (Civil)

Refer to Type Section & Pavement detail drawings 824424-824425
for As Constructed information

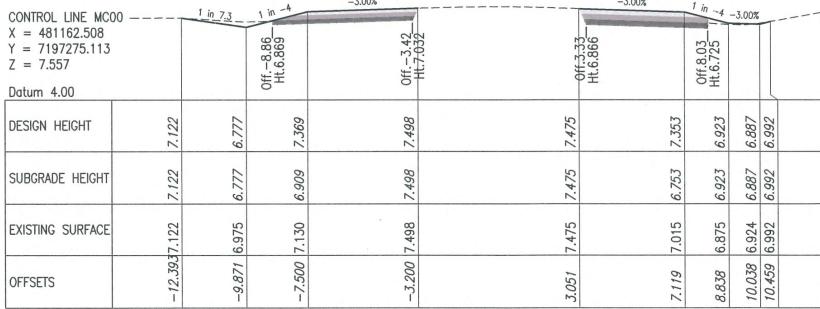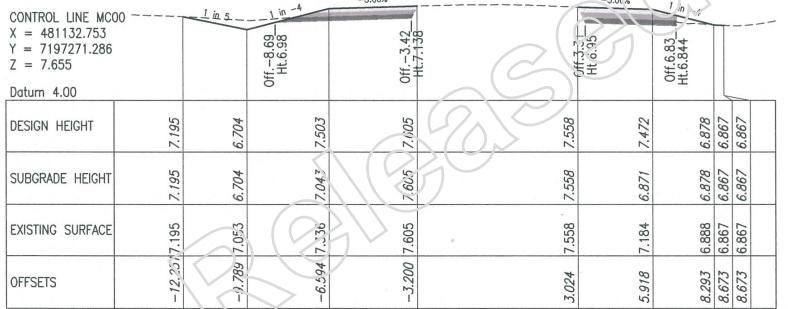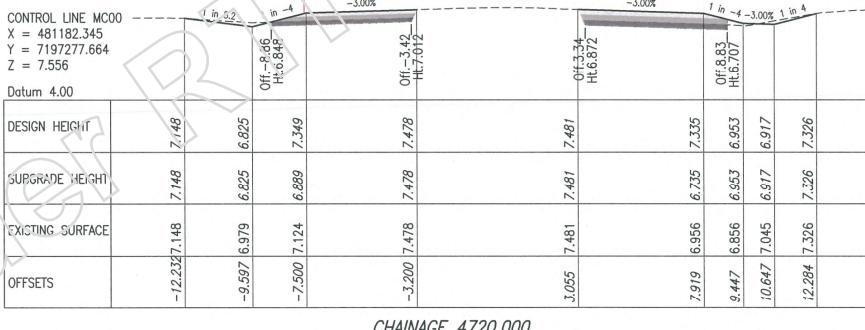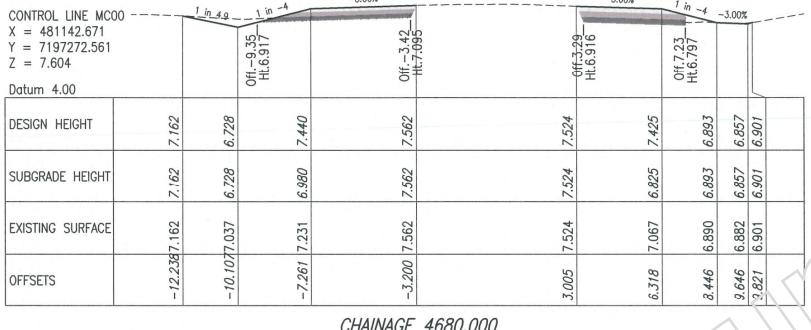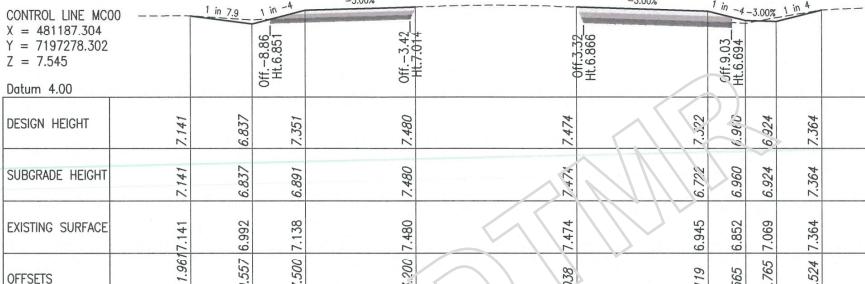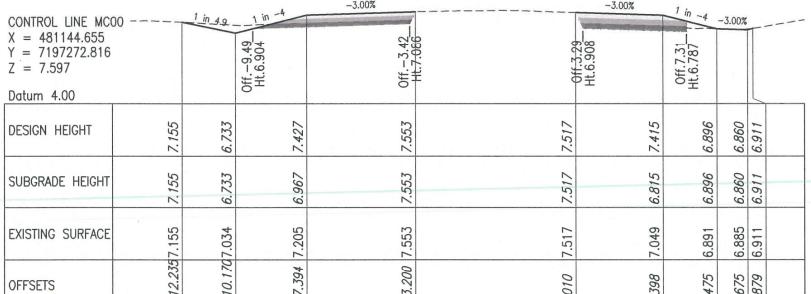

G			
D	R		
C			
B As Constructed	NR	25/2/2020	
A Issued for Construction			
Revisions/Descriptions	Certification	Date	Microfiled
CAD FILES G:\BUND\TechServ\Projects\228 Fraser Coast\228 1632 1075873 Woods Rd SRS\Design\ACAD\824428_XS_AscCon.dwg			

Associated Job Nos

Survey Data

Datum GDA 94

Horiz.

Grid MGA 94, Z56

Auxiliary Drg Nos

Grid

AHD DERIVED

Height Origin

AHD DERIVED

Survey Books

228109

Dimensions shown in metres except where shown otherwise

Scales

0

1

2

3

4m

FRASER COAST REGIONAL COUNCIL

BOORAL ROAD (1632)

CTL CHGE 4640 - 4950

Reference Points

Preceding RP

Dist. to start of job (km)

From start to end of job

From end to Following RP

Following RP

1A

4.64

.31

4.969

2

Through Chainage from INT 163/1632/164, 4.64 - 4.95km

ANNOTATED ROAD CROSS SECTIONS MC00 SHEET 2 OF 6



Queensland Government

Job No. 228/1632/1075873

Contract No. CN-13066

Drawing No. 824429 B

Series Number 08 of 12


MRR Detail (02/14)

Refer to Type Section & Pavement detail drawings 824424-824425
for As Constructed information

CONTROL LINE MC00
X = 481207.140
Y = 7197280.853
Z = 7.563

Datum 4.00

DESIGN HEIGHT
SUBGRADE HEIGHT
EXISTING SURFACE
OFFSETS

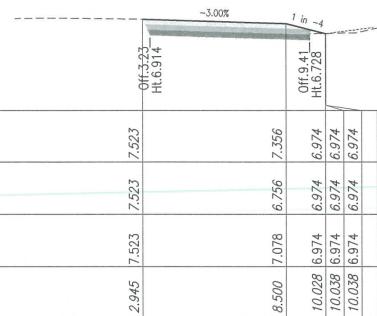


CHAINAGE 4745.000

CONTROL LINE MC00
X = 481202.181
Y = 7197280.215
Z = 7.546

Datum 4.00

DESIGN HEIGHT
SUBGRADE HEIGHT
EXISTING SURFACE
OFFSETS

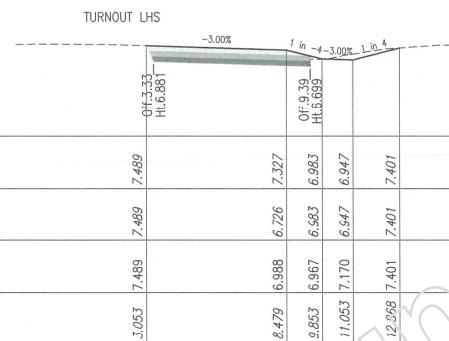

CHAINAGE 4740.000

CONTROL LINE MC00
X = 481200.198
Y = 7197279.960
Z = 7.547

Datum 4.00

DESIGN HEIGHT
SUBGRADE HEIGHT
EXISTING SURFACE
OFFSETS



CHAINAGE 4738.000

Last Modified: Feb 25, 2020 - 12:25pm XREFS: -





NR 25/2/2020

G					Associated Job Nos	Survey Data	Scales	FRASER COAST REGIONAL COUNCIL	ANNOTATED ROAD CROSS SECTIONS MC00	Queensland Government
D	R				Auxiliary Drg Nos	Datum GDA 94				
C						Horiz. Grid MGA 94, Z56				
B						Height Origin AHD DERIVED				
A						Survey Books 228109				
							0 1 2 3 4m	BOORO ROAD (1632)		
								CTL CHGE 4640 - 4950		
								Reference Points	Sheet 3 of 6	Engineering Certification (RPEQ)
								Preceding RP	Drawn D. Riemer	ENG. AREA NAME SIGNATURE NO. DATE
								Dist. to start of job (km)		CIVIL Vince Green Vince Green 10577 05/11/19
								From start to end of job		
								From end to Following RP		
								1A 4.64 .31 4.969 2		
								Through Chainage from INT 163/1632/164, 4.64 - 4.95km		
										MRR Detail (02/14)

Refer to Type Section & Pavement detail drawings 824424-824425
for As Constructed information

The works shown on this drawing are a factual representation of the works constructed.

Signature **NR** Date **26/02/2020**
Name **Gakul Gurung (RPEQ 18777)**
Title **Engineer (Civil)**

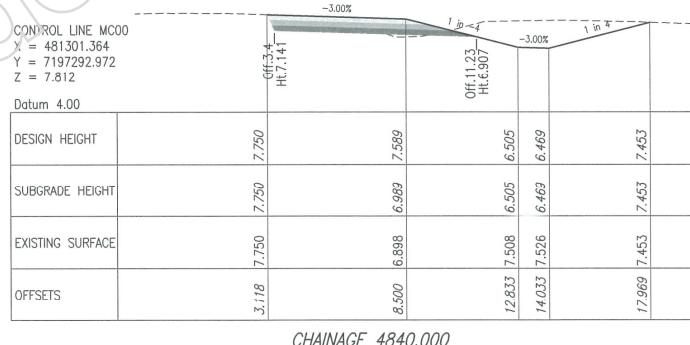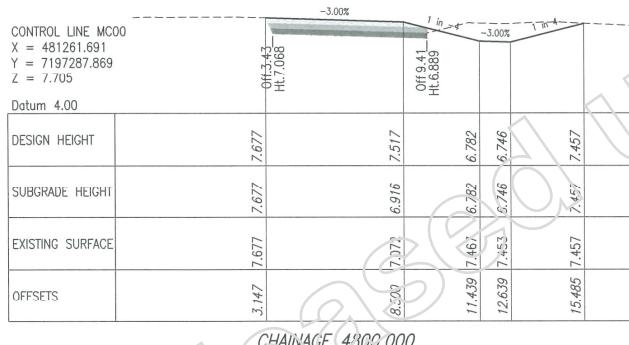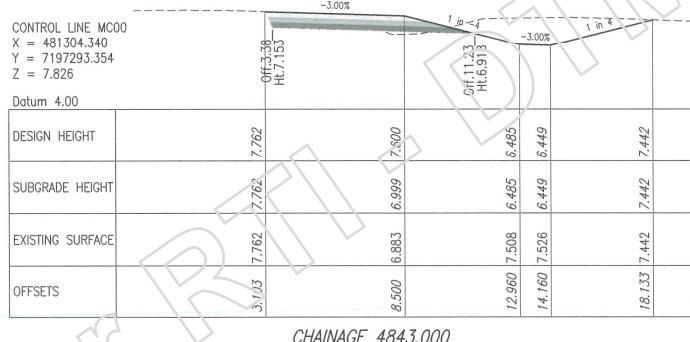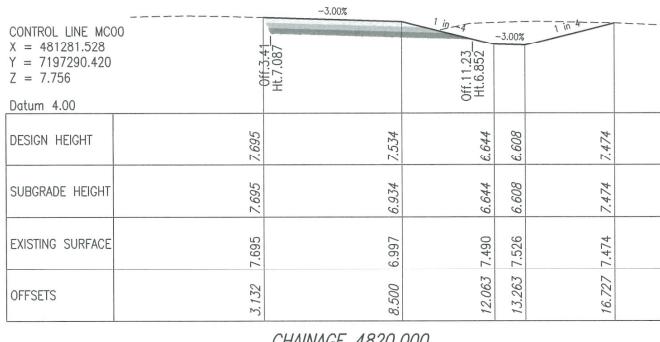

G	F	E	D	C			
B As Constructed					Associated Job Nos	Survey Data	Scales
A Issued for Construction					Datum	GDA 94	0 1 2 3 4m
Revisions/Descriptions	Certification	Date	Microfilmed		Auxiliary Org Nos	Horiz. Grid MGA 94, Z56	
				824422 - 824433	Height Origin	AHD DERIVED	
				Survey Books	228109	Dimensions shown in metres except where shown otherwise	

NR **25/2/2020**

Last Modified: Feb 25, 2020 - 12:25pm REF'S: -

CAD FILES: G:\BUND\TechServ\Projects\228 Fraser Coast\228 1632 1075873 Woods Rd SRS\Design\ACAD\824428 XS_AsCon.dwg

FRASER COAST REGIONAL COUNCIL
BOORAL ROAD (1632)
CTL CHGE 4640 - 4950

Reference Points

Preceding RP	Dist. to start of job (km)	From start to end of job	From end to Following RP	Following RP
1A	4.64	.31	4.969	2

Dimensions shown in metres except where shown otherwise




Through Chainage from INT 163/1632/164, 4.64 - 4.95km

ANNOTATED ROAD CROSS SECTIONS MC00
SHEET 4 OF 6



Refer to Type Section & Pavement detail drawings 824424-824425
for As Constructed information

The works shown on this drawing are a factual representation of the works constructed.
 Signature **NR** Date **26/02/2020**
 Name **Gakul Gurung (RPEQ 18777)**
 Title **Engineer (Civil)**

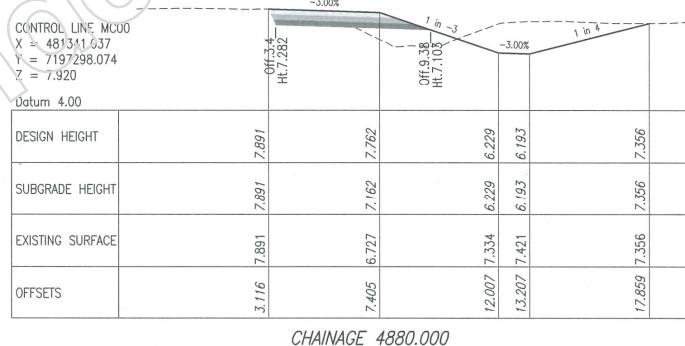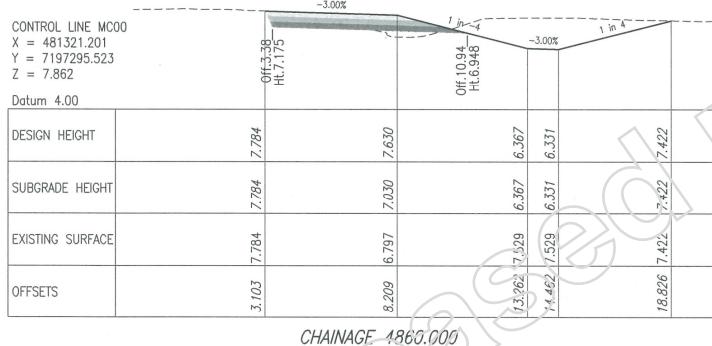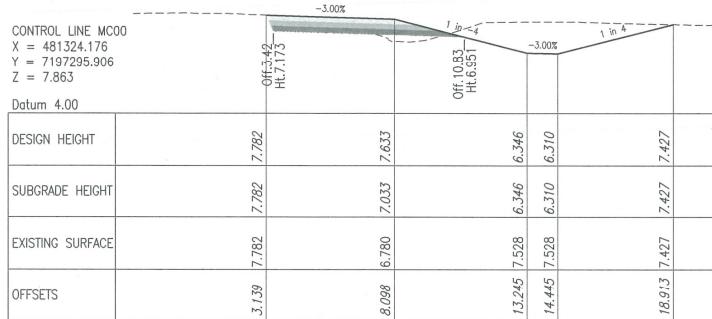

Refer to Type Section & Pavement detail drawings 824424-824425
for As Constructed information

The works shown on this drawing are a factual representation of the works constructed.

NR

Signature _____
Name Gakul Gurung (RPEQ 18777)
Title Engineer (Civil)

Date 26/02/2020

CONTROL LINE MC00
X = 481380.711
Y = 7197303.177
Z = 8.194

Datum 4.00

DESIGN HEIGHT	
SUBGRADE HEIGHT	
EXISTING SURFACE	
OFFSETS	

CHAINAGE 4920.000




CONTROL LINE MC00
X = 481377.735
Y = 7197302.794
Z = 8.171

Datum 4.00

DESIGN HEIGHT	
SUBGRADE HEIGHT	
EXISTING SURFACE	
OFFSETS	

CHAINAGE 4917.000

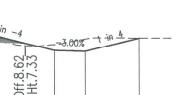


CONTROL LINE MC00
X = 481400.549
Y = 7197305.719
Z = 8.393

Datum 4.00

DESIGN HEIGHT	
SUBGRADE HEIGHT	
EXISTING SURFACE	
OFFSETS	

CHAINAGE 4940.000

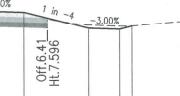


CONTROL LINE MC00
X = 481390.829
Y = 7197304.453
Z = 8.272

Datum 4.00

DESIGN HEIGHT	
SUBGRADE HEIGHT	
EXISTING SURFACE	
OFFSETS	

CHAINAGE 4930.000

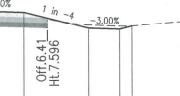


CONTROL LINE MC00
X = 481404.521
Y = 7197306.188
Z = 8.446

Datum 4.00

DESIGN HEIGHT	
SUBGRADE HEIGHT	
EXISTING SURFACE	
OFFSETS	

CHAINAGE 4950.000

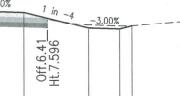

Associated Job Nos
Auxiliary Org Nos
Survey Books

Datum GDA 94
Horiz Grid MGA 94, Z56
Height AHD DERIVED
Origin 228109

Dimensions shown in metres
except where shown otherwise

Scales
0 1 2 3 4m

FRASER COAST REGIONAL COUNCIL
BOORAL ROAD (1632)
CTL CHGE 4640 - 4950
Reference Points
Preceding Dist. to start From start to From end to Following Following
RP of job (km) end of job RP RP
1A 4.64 .31 4.969 2

Through Chainage from INT 163/1632/164, 4.64 - 4.95km

CONTROL LINE MC00
X = 481410.486
Y = 7197306.833
Z = 8.345

Datum 4.00

DESIGN HEIGHT	
SUBGRADE HEIGHT	
EXISTING SURFACE	
OFFSETS	

CHAINAGE 4950.000



CONTROL LINE MC00
X = 481404.521
Y = 7197306.188
Z = 8.446

Datum 4.00

DESIGN HEIGHT	
SUBGRADE HEIGHT	
EXISTING SURFACE	
OFFSETS	

CHAINAGE 4944.000



228/1632/1075873 – Booral Rd & Woods Rd Intersection Upgrade

Safety in Design Report

October 2019



Creative Commons information

© State of Queensland (Department of Transport and Main Roads) 2015



<http://creativecommons.org/licenses/by/4.0/>

This work is licensed under a Creative Commons Attribution 4.0 Licence. You are free to copy, communicate and adapt the work, as long as you attribute the authors.

The Queensland Government supports and encourages the dissemination and exchange of information. However, copyright protects this publication. The State of Queensland has no objection to this material being reproduced, made available online or electronically but only if its recognised as the owner of the copyright and this material remains unaltered.



The Queensland Government is committed to providing accessible services to Queenslanders of all cultural and linguistic backgrounds. If you have difficulty understanding this publication and need a translator, please call the Translating and Interpreting Service (TIS National) on 13 14 50 and ask them to telephone the Queensland Department of Transport and Main Roads on 13 74 68.

Disclaimer: While every care has been taken in preparing this publication, the State of Queensland accepts no responsibility for decisions or actions taken as a result of any data, information, statement or advice, expressed or implied, contained within. To the best of our knowledge, the content was correct at the time of publishing.

Document control options

Prepared by	Darryl Riemer
Title	Senior Designer (Civil)
District & Region	Wide Bay / Burnett District, North Coast Region
Branch & Division	Program Delivery and Operations
Project/program	SRS Booral Rd (1632) & Woods Rd Intersection Upgrade
Project number	228/1632/1075873
Project location	4.640km – 4.950km on Booral Rd (1632)
Status	Final Submission
DMS ref. no.	450/01777

Contents

1	Introduction	4
1.1	Purpose of this document	4
2	Project Details	4
2.1	Project name and description	4
3	Risk Assessment Methodology	4
3.1	Scope of SiD process	4
3.1.1	Scope	4
3.1.2	Structure	4
3.1.3	Objectives	4
3.1.4	Risk Treatment	4
4	SiDR Consultation Outcomes	5
5	Safety in Design Risk Categories	5
6	Recommendations	5
7	Attachments	5

1 Introduction

1.1 Purpose of this document

This document demonstrates that the project team has considered impacts of the proposed design in accordance with the Workplace Health and Safety - Work Health and Safety Act (2011) and Work Health and Safety Regulation (2011).

This is achieved by identifying and reviewing possible WHS hazards and risks during construction, operation, maintenance, and demolition of this project, as outlined in the Road Planning and Design Manual Volume 3, Part 8 Process and Documentation.

2 Project Details

2.1 Project name and description

Upgrade existing intersection at Woods Rd to CHR(s) with AUL(s), including vegetation clearing and other upgrades as required. Pavement widening Ch.4.640km to 4.950km on 1632, 228/1632/1075873. Detail Design of widening with new granular pavement for Safer Roads Sooner project.

3 Risk Assessment Methodology

3.1 Scope of SiD process

3.1.1 Scope

Identify, through consultation with key stakeholders, the possible WHS hazards and design risks that may occur during construction, operation, maintenance, and demolition of this project and advise on atypical or unique hazardous areas, including recommendation of mitigating measures, to reduce the WHS risks.

3.1.2 Structure

The detail contained in this report is drawn from the outcomes of Safety in Design consultations with key stakeholders for the design and construction of this project.

The key stakeholder disciplines for this project are: Designer, RPEQ, Construction Engineer, and Maintenance Engineer.

The outcomes of the SiD consultations are noted in Section 4 of this report.

3.1.3 Objectives

The objective of the Safety in Design consultations is to identify unusual or atypical features that could pose a risk to anyone carrying-out construction, operation, maintenance, and demolition of any areas on this project.

3.1.4 Risk Treatment

The risk assessment methodology adopted for this report involves identifying hazards, assessing the risks, controlling the risks and reviewing the control measures, based on the TMR Managing Safety Hazards and Risks Procedure.

4 SiDR Consultation Outcomes

SID consultation dates: 18/10/2019

Attendees: Vince Green (Project Manager & RPEQ)

Mitch Curd (Maintenance Engineer)

Following a review of the detail design drawings for the project it was agreed that the project was a typical widening job designed using the latest road planning and design standards that could be constructed using typical construction practices.

There are no unique areas that would pose an unexpected hazard during construction, operation, maintenance, and demolition of this project.

5 Safety in Design Risk Categories

The following areas were considered for design risks:

- Roads and Drainage
- Geotechnical / Geology
- Hydraulics / Hydrology
- Public Utility Plant
- Environmental
- Electrical / Lighting
- Constructability
- Maintenance

6 Recommendations

There are no unique areas identified for this project that would require additional mitigating measures to standard WHS practices.

This report is to be provided as part of the handover documentation to the Contract Administrator for communication to the Contractor and reference in the Post Construction Report for Job No. 228/1632/1075873.

7 Attachments

None

Project Scope Identification

for an Infrastructure Type 3 project



Source of funds:
(Program, line item in RIP)

Safer Roads Sooner

Region/District:

Wide Bay Burnett

Local Government:

Fraser Coast Regional Council

Road Name (Section):

1632 Booral Road

Project Location:

Start (Ch/TDist/Co-ord)	Finish (Ch/TDist/Co-ord)	Site No	Distance
TDist 4.65km	5.05km	3124	230m

Project Number:

TBA

Existing conditions:

Booral Road serves as an alternate entry into Hervey Bay and connects to the airport and Fraser Island departures. The road serves a growing residential area catchment and incorporates various local road intersections which lead into Hervey Bay. The traffic volume of Booral Road has experienced higher than normal growth of around 4% over the past ten years, with additional growth planned as further areas to the south of Hervey Bay are developed. Booral Road has a speed limit of 100km/h at the intersection of Booral Rd and Woods Rd. The intersection of Woods Road is a main connection to Hervey Bay as it links directly to Urraween Road.

The intersection is give way priority controlled and has no turn lane facilities. Woods Road consists of a single lane approach and has a posted speed limit of 100km/h.

Need for Project:

This intersection is currently ranked as a District's medium priority in QRAM and has had an increasing number of crashes and near misses in recent years. Given the increase in population in this area this trend is anticipated to continue.

Date of any damage:

N/A

• Crash history:

(7 June 2013- 6 June 2018)

There have been two recorded injury crashes in the most recent five years validated crash history at this location::

- 104H, 1700, dry, - S/B Right turn from Woods Rd into Booral failed to GW
- 303MI, 1500, dry – W/B Right turn on Booral Rd was rear-ended

• AADT (% of heavy vehicles) (2017):

1632 Tdist 0.0-6.484km 5,855 (11.73% HV).

Woods Rd – 1,656vpd total (from 12 hour count on 9/5/18)

• Deficiencies:

- Lack of any right turn lane provision into Woods Rd (not even BAR standard)
- Lack of any left lane into Woods Road

• Political and community issues:	Has been in media.
• Any associated works/projects:	There are no planned projects in the vicinity of this proposal.
• Other: <i>(provide photos where applicable):</i>	Refer to photos below.
Program Benefits/ outcomes of proposed works:	<ul style="list-style-type: none"> • Improve turning traffic safely by providing protected turn lanes • Improving Booral Road traffic flow by eliminating need to slow for turning vehicles

Scope of proposed project:	
• In Scope:	<ul style="list-style-type: none"> • Provide CHR right turn lane • Provide AUL (S) left turn lane • Provide widening to accommodate turn lanes
• Out of Scope:	<p>The following works are not within the current scope</p> <ul style="list-style-type: none"> • Repairs of existing pavement • Kerb or drainage alteration
Options considered:	<ul style="list-style-type: none"> • A CHR(S) option was considered but traffic volumes were very close to warrant a CHR so this was adopted to cater for future traffic increases.
Constraints:	<ul style="list-style-type: none"> • Verified cost estimate of \$325,000
Delivery method:	MIC-SI (RoadTek)
Safety assessment	<p>Does the proposed work make any aspect of the road less safe? (e.g. traffic moved closer to hazards, or approach speed to a tight curve increased)</p> <p>No, <input checked="" type="checkbox"/> - proceed with the design</p> <p>Yes, <input type="checkbox"/> - do further mitigation work to achieve the appropriate level of safety.</p>
Future operational performance:	Improved access to the road, reduced crashes and increased main road efficiency due to less disruption of through traffic.
Significant risks identified:	No issues foreseen.
Native Title/Environmental/Cultural Heritage concerns:	Native title and cultural heritage are not a concern as works are in disturbed road corridor.
Project Estimate: <i>(note contingency allowance)</i>	\$325,000 (Including \$49K contingency)

Source Fund \$'000	Proposed expenditure flows				
	Prior Expenditure \$'000	2017-18 \$'000	2018-19 \$'000	2019-20 \$'000	Total \$'000
325	-	-	-	325	325

Submitted (Project Manager)

Name: Vince Green Signature: _____	Position: Senior Traffic Engineer Date: <u>20 / 7 / 2018</u>
Not Relevant	

Recommended (Program Manager/Sponsor- Principal Engineer/Advisor/Coordinator)

Name: Brendan Clancy Signature: _____	Position: Manager (Delivery and Operations) Date: <u>26 / 7 / 18</u>
Not Relevant	

Comments:

Approved (Customer - M(PD&P), M(D&O) or M(PP&CM))

Name: Hennie Roux Signature: _____	Position: District Director Date: <u>27 / 07 / 2018</u>
Not Relevant	

Comments:

Attachments:

- A. Locality Map
- B. DVR Site Photos
- C. Cost Estimate
- D. Concept Design

APPENDIX A - LOCALITY MAP



APPENDIX B – Site Photos

Tdist 4.630 km (WG) – eastbound approach to intersection



Tdist 5.010km (AG) – looking westbound towards intersection.



Tdist 4.850km (AG) – looking westbound towards intersection.



Woods Road – looking south towards Booral Rd



APPENDIX C – Cost Estimate



Queensland Government

Project Number : TBA

Project Boundary : State Wide

Asset Name : Booral Road

Location : Woods Road intersection Tdist 4.76km

NOTE: Estimate must be considered absolutely as the property of Transport and Main Roads until the acceptance of a tender, and must

Stage : final - construction

Stage : final - construction

Work Package : Construction - concept

Item Number	Description	Unit of Measure	Quantity	Unit Rate (\$)	Amount (\$)
MRS02 Jul 17					
20001.01	PROVISION FOR TRAFFIC	lump sum			\$20,000.00
MRS03 Mar 18					
	DRAINAGE REMOVAL/DEMOLITION				
30002	Removal or demolition of culvert end structures	lump sum			\$500.00
	SUPPLY AND INSTALLATION OF CULVERTS				
30251.01	Supply and installation of concrete pipe culvert components, Class 3, 900mm diameter	m			\$2,562.00
	CONCRETE IN CULVERTS AND END STRUCTURES				
30366.01	Precast concrete end structures to culverts, [1/900 RCP]	each			\$3,000.00
MRS04 Jan 18					
	EARTHWORKS, PREPARATION				
32001.01	Clearing and grubbing	m ²			\$7,500.00
32003.01P	Stripping of topsoil (Provisional Quantity as directed)	m ³			\$1,335.00
	EARTHWORKS, EXCAVATION				
32101.01	Road excavation, all materials	m ³			\$16,800.00
	EARTHWORKS, SUBGRADE				
32306.01P	Subgrade treatment Type A	m ²		Sch.4 Part 4 s.7(1)(c) Bus/comm affairs	\$6,280.00
32310.01P	Subgrade treatment Type B, replace with select fill material (Provisional Quantity if ordered) (250mm depth)	m ³			\$12,000.00
MRS05 Jul 17					
	UNBOUND PAVEMENTS				
40002.01	Type 2.1 Unbound Pavement [200mm base]	m ³			\$51,475.00
40004.01	Type 2.3 Unbound Pavement [150mm sub base]	m ³			\$36,045.00
MRS11 Oct 17					
	SPRAYED BITUMINOUS SURFACING (EXCLUDING EMULSION)				
40802.01	Primerseal, grade [AMC7], spray rate [1.1], [excluding] supply of binder, [In widening]	litre			\$2,935.50
40803.01	Seal, class [C170], spray rate [1.2], [excluding] supply of binder, [In widening]	litre			\$2,668.75
40806.01	Spreading prime cover material [10mm], [120m ²],	m ³			\$2,400.00
40807.01	Spreading cover aggregate [14mm], [90m ²],	m ³			\$2,500.00
MRS14 Mar 18					

REMOVAL, DEMOLITION AND RE-ERCTION				
50002.01	Removal and salvage of road furniture, as listed in Clause 1.1 of Annexure MRTS14.1	lump sum		\$2,500.00
50003.01	Removal and re-erection of road furniture, as listed in Clause 4 of Annexure MRTS14.1	lump sum		\$2,000.00
GUIDANCE AND INFORMATION SYSTEMS				
50051.01	Road edge guide posts	each		\$1,200.00
50053.01	Supply of regulatory, warning and hazard sign faces, [sign type]	each		\$300.00
50057.01	Installation of regulatory, warning and hazard signs	lump sum		\$400.00
MRS16				
GROUND PREPARATION WORKS - TOPSOIL				
50803.01	Install topsoil [50mm] (Provisional Quantity as directed)	m2		\$8,750.00
VEGETATION WORKS - SEEDING				
50853.01P	Drill seeding [mix name] (Provisional Quantity as directed)	m2		\$1,750.00
MRS22				
SUPPLY OF COVER AGGREGATE				
41001.01	Supply of cover aggregate [precoated], [10] mm nominal size	m2		\$8,895.00
41002.01	Supply of cover aggregate [precoated], [14] mm nominal size	m2		\$1,779.00
MRS28 Mar 18				
20101.01	CONTRACTOR'S SITE FACILITIES AND CAMP	lump sum	Sch.4 Part 4 s.7(1)(c) Bus/comm affairs	\$10,000.00
MRS45 Oct 17				
LINE MARKING				
52101.01	Spotting only for longitudinal lines	m		\$2,467.50
52104.01	Barrier line, single, 100 mm wide	m		\$125.00
52110.01	Edge line, 150 mm wide, colour [colour], material [material]	m		\$1,600.00
52111.01	Continuity line, 200 mm wide, colour [colour], material [material]	m		\$750.00
52113.01	Outline, 150 mm wide, colour white material waterbourne	m		\$1,000.00
52116.01	Transverse lines (stop lines, holding lines, markings at Stop and Give Way signs, pedestrian crosswalk lines, arrows, shapes, symbols and numerals), colour [colour], material [material]	m2		\$810.00
52117.01	Transverse lines (diagonal and chevron markings, parking areas and kerb markings), colour [white], material [water borne type 3]	m2		\$28,350.00
RAISED PAVEMENT MARKERS				
52201.01	Retroreflective raised pavement markers	each		\$1,750.00
MRS51 Jul 17				
ENVIRONMENTAL MANAGEMENT				
20202.01	Develop Environmental Management Plan (Construction)	lump sum		\$1,000.00
20203.01	Implement Environmental Management Plan (Construction)	lump sum		\$1,500.00
Work Package Total :				\$244,927.75


Work Package : preconstruction - PRECON

Item Number	Description	Unit of Measure	Quantity	Unit Rate (\$)	Amount (\$)
MRP06 Jul 17					
PROJECT STAGE MANAGEMENT (ALL STAGES)					
15010.01	Project management - general (time, cost, quality, HR management)	lump sum			\$5,000.00

15070.01	Community engagement	lump sum		\$1,000.00
MRP09 Jul 17				
	Public Utility Plant			
18010.01	Public Utility Plant identification	lump sum		\$1,000.00
MRP008 May 11				
	DESIGN INVESTIGATION REPORTS			
18080.01	Engineering survey	lump sum		\$8,000.00
MRP009 May 11				
	ENGAGE AND MANAGE DESIGN SERVICES			
19100.01	Detailed road design	lump sum		\$15,000.00
MRP011 Jul 17				
	PRINCIPAL'S OBLIGATIONS			
19150.01	Portable long service leave, levies and fees.	lump sum		\$1,164.00
9001.01P	Contingency (provisional cost) (Provisional Quantity as directed)	lump sum		\$48,985.55
Work Package Total :				\$80,149.55
Stage Total :				\$325,077.30



View to Woods Road from about 300m east of the intersection.

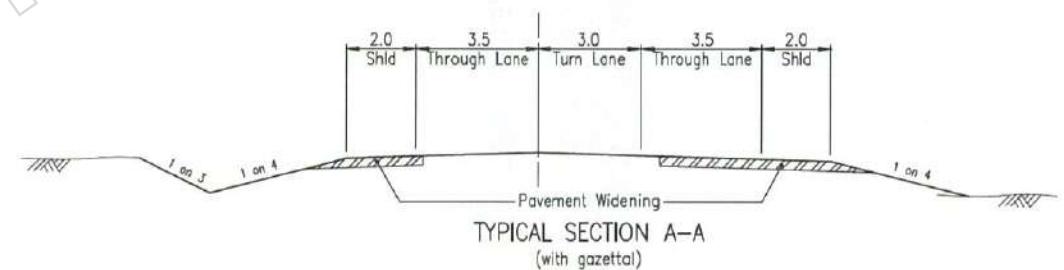

NOTES:

DESIGN SPEED: 110km/h
AADT: 5,105 vpd
HEAVY VEHICLES: 11%
THROUGH LANE WIDTH: 3.5m
SHOULDER WIDTH: 2.0m


TREATMENT: CHR
DECCELERATION: 1.35m
LATERAL SHIFT (A): 95m
STORAGE: 20m
TAPER: 30m
RIGHT TURN LANE WIDTH: 3.0m

TREATMENT: AUL(S)
DECCELERATION: 85m
TAPER: 30m
LEFT TURN LANE WIDTH: 3.0m
SHOULDER WIDTH: 1.0m



NOTES:

- Service locations are indicative only and derived from aerial photo and DBYD information.
- All layouts are conceptual with design based on an aerial photo only.
- Pavement design for widening to be determined in next project phase.

G				Associated Job Nos	Survey Data	Scales	FRASER COAST REGIONAL COUNCIL				INTERSECTION IMPROVEMENTS						
F				Auxiliary Org. Nos	Datum	0 5 10 15 20m	1632				WOODS ROAD						
E				Horiz. Grid			CTL CHGE				CHR AUL(S)						
D				Height	Origin		Preceding RP	Dist. to start of job (km)	From start to end of job	From end to Following RP	Following RP	Drawn	ENGINEERING CERTIFICATION (RPEQ)				
C				Survey Books		Dimensions shown in metres except where shown otherwise						R MCNEILL	ENG. AREA	NAME	SIGNATURE	NO. DATE	
B						Through Change from						Designed					
A	Issued for Construction											R MCNEILL					
	Revisions/Descriptions	Certification	Date	Microfiled													MRR_Detail (02/14)
CAD FILES	G:\BUND\TechServ\Planning\HBUP\2017\1632\Autocad\1632 Int Layouts.dwg																

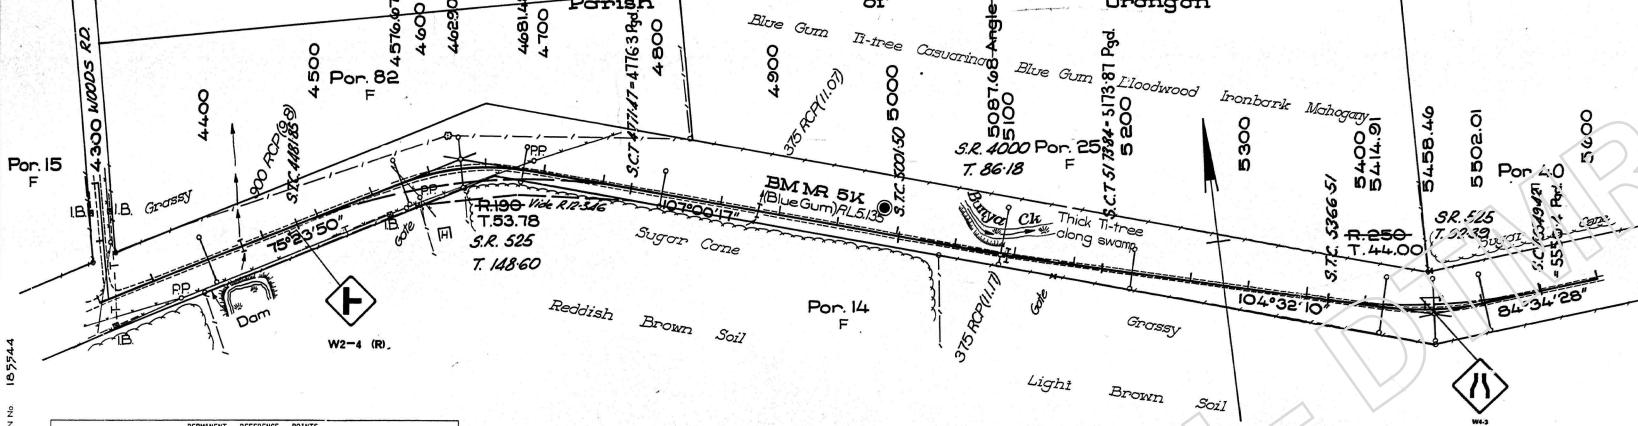

PERMANENT REFERENCE POINTS					
Preceding PRP Name	Dist. to Start of Job km	Dist. - Start to End of Job km	Dist. from End to Following PRP km	Following PRP Name	
MS 77296 R	4.28	1.30	3.86	MS 662966 K	

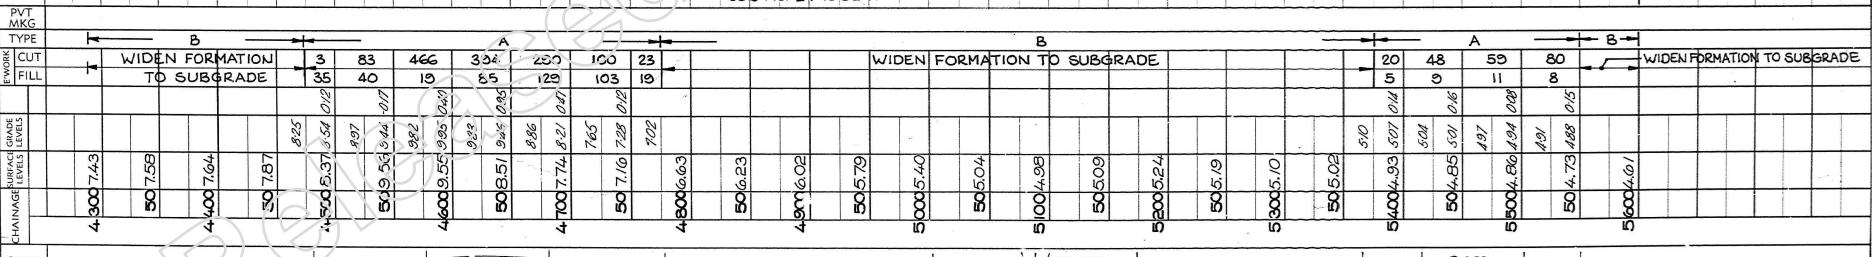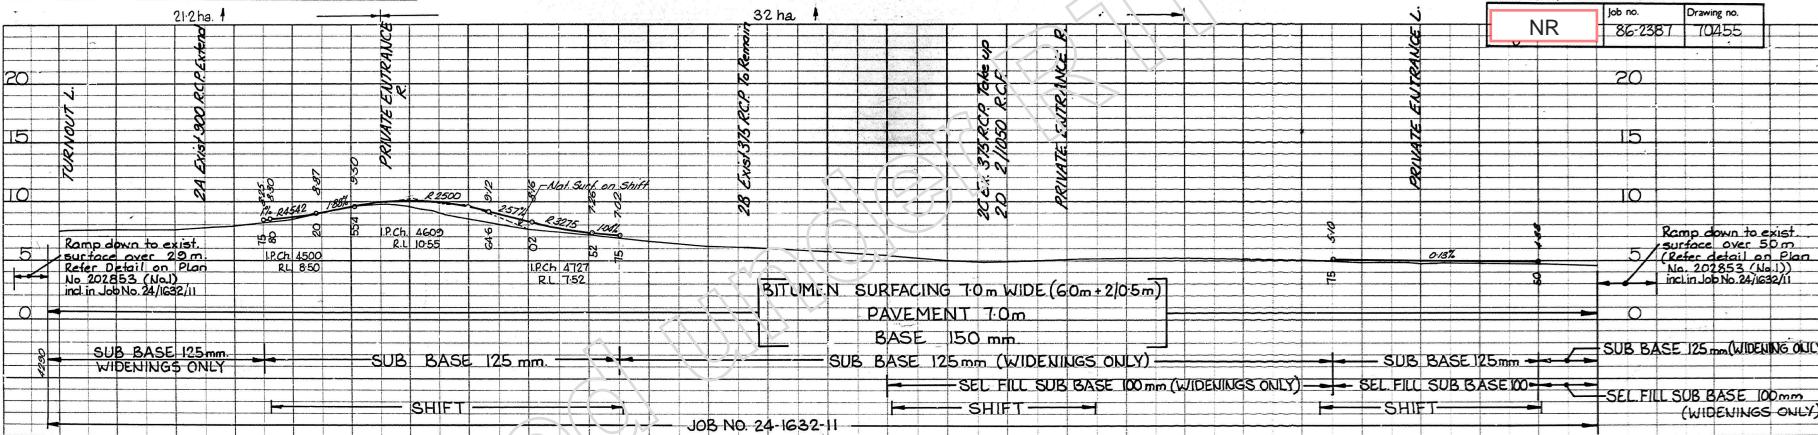


CURVE DATA	Revisions		Issue Date		Microfilm		Associated Job Nos	Full Size		Offset Pcs	R.L.	B.M. on Chainage	Dist.	R.L.	Surveyed	Not Surveyed	BENCH MARKS	THROUGH CHAINAGE FROM MARYBOROUGH - URANGAN ROAD						MAIN ROADS DEPT. HERVEY BAY CITY	JOB No.		
	1	2	3	4	5	6		A1	1: 200																		
								0 20 40 60	FULL SIZE																		
								Plan & Horiz. Sect.	Vertical Section																		
								19447, 202853, 4																			
A	Original Issue	22/12/06	ME 191A																								

DESIGN SPEED km/h


Cameron McNamara
Cameron McNamara Pty Ltd
(Incorporated in Queensland)

Job no. Drawing no.
NR 86-2387 10455

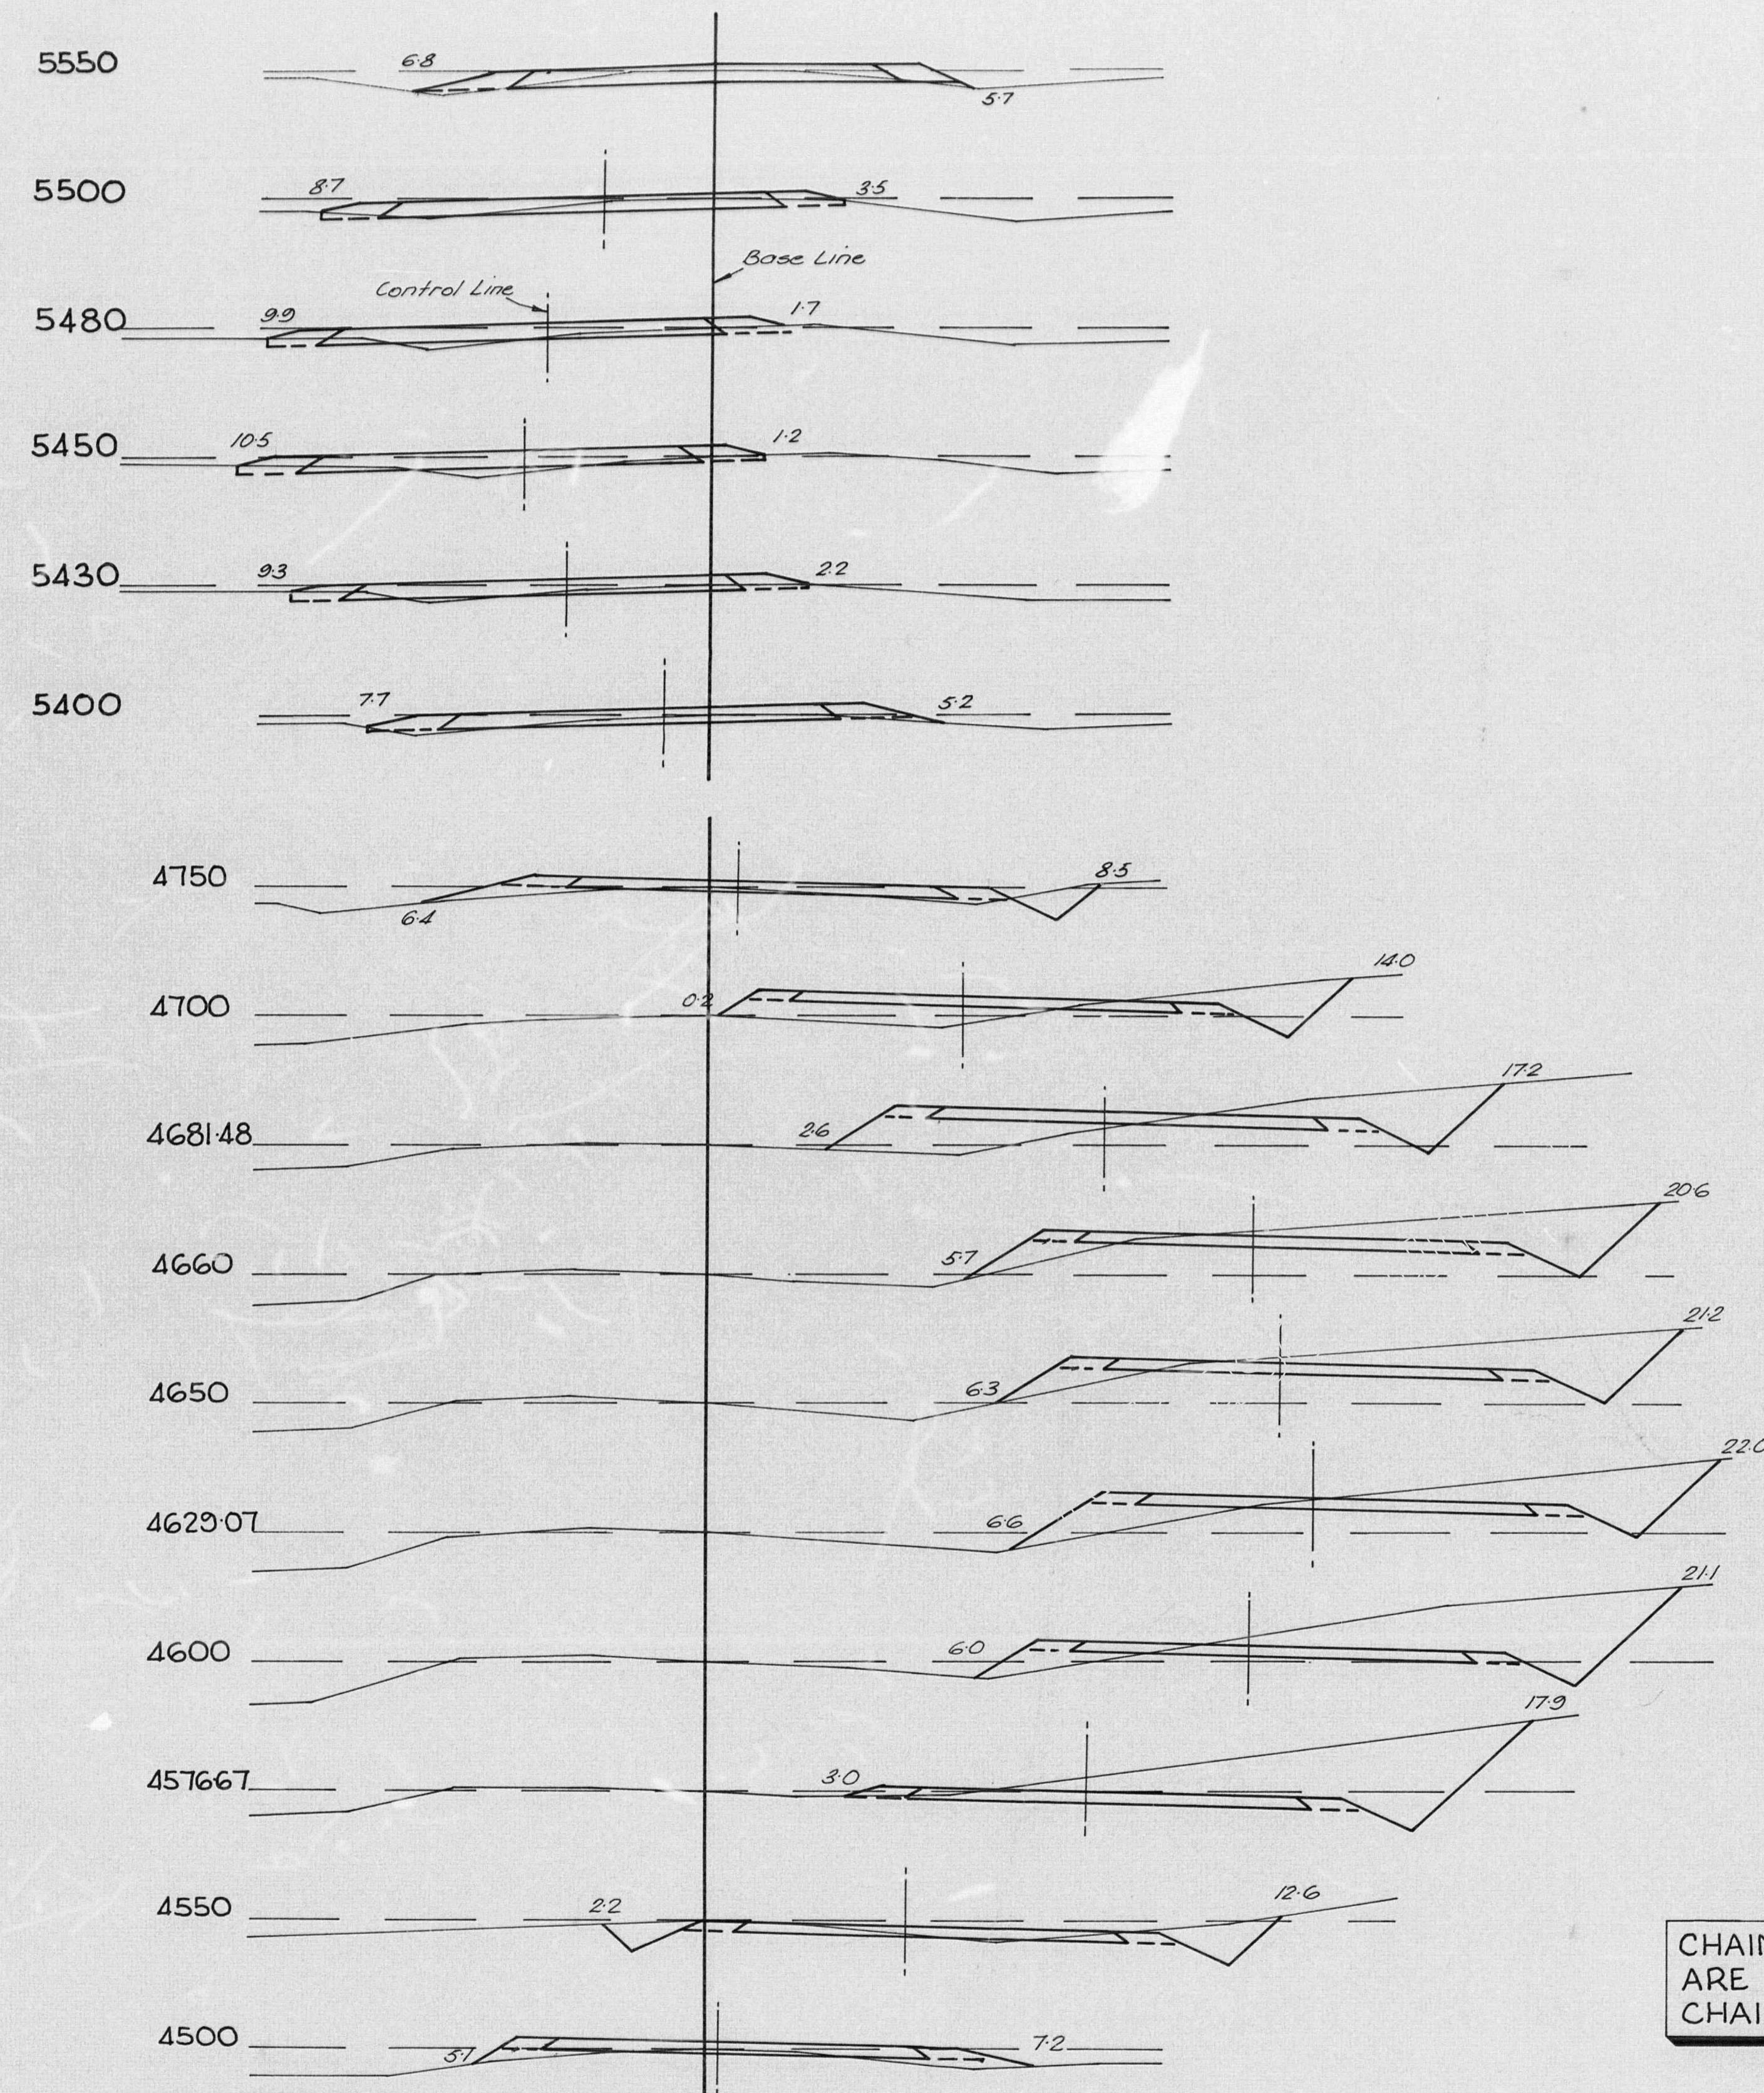

CROSS SECTIONS

CHAINAGES SHOWN
ARE BASE LINE
CHAINAGES

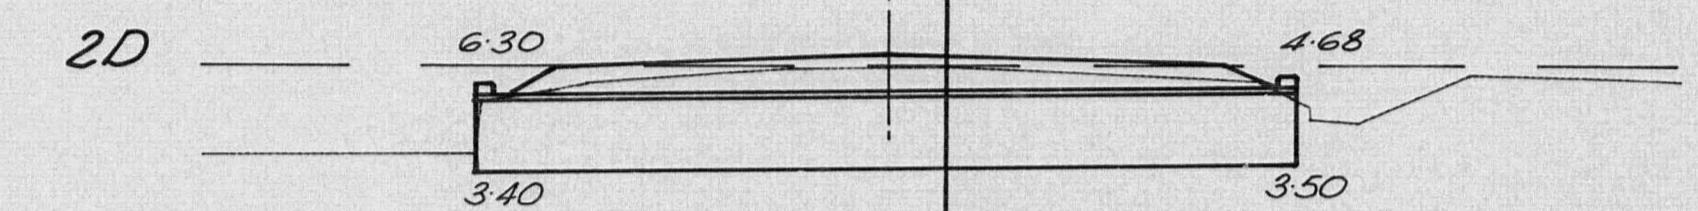

2/1050 R.C.P.(10.98m) 50935 (X)

DWG. 1124 & 1126
BACKFILL 47 m³ : EXCAV 140 15 m³
WINGWALLS TYPE 1 (L1-L2=1700) CONC 5.2 m³
APRONS TYPE 1 - STONE PITCHING 10 m²

2C EXIST. 375 R.C.P. of 50935 : TAKE UP & STACK

2B EXIST. 375 R.C.P. (9.9m) of 48824 : TO REMAIN

2A EXIST. 900 R.C.P. (9.76m) of 4430 : EXTEND 1.22m R.

DWG. 1124 & 1126 : PROVIDE WINGWALLS & APRONS
TO EXIST. ENDWALL ON L.H.S.
BACKFILL 5 m³ : EXCAV 140 4 m³
WINGWALLS TYPE 1 (L1-L2=1400) CONC 2.8 m³
APRONS TYPE 1 - STONE PITCHING 4 m²

DRAINAGE


Cameron McNamara

Cameron McNamara Pty Ltd
(Incorporated in Queensland)

NR	Job no. 86-2387	Drawing no. 70456
----	--------------------	----------------------

Revisions		Issue Date		Associated Job Nos		Dimensions in metres except where shown otherwise. Culvert sizes in millimetres.		THROUGH CHAINAGE FROM MARYBOROUGH - URANGAN RD.		MAIN ROADS DEPARTMENT		HERVEY BAY CITY BOORAL ROAD 4290 - 5600		CROSS SECTIONS & DRAINAGE					JOB NO.	
																		24-1632-11		
				Auxiliary Plan Nos 104147, 202853, 4		SCALES	0 1 2 3 4 5 m	FULL SIZE A1	SURVEY BOOKS 1632-21,22	Preceding PRP Name	Dist. to Start of Job km	Dist. Start to End of Job km	Dist. from End to Following PRP km	Following PRP Name	Boundaries	Not Relevant			No. 3 OF 3 PLANS	PLAN NO. 202854


Johns Plan 287208

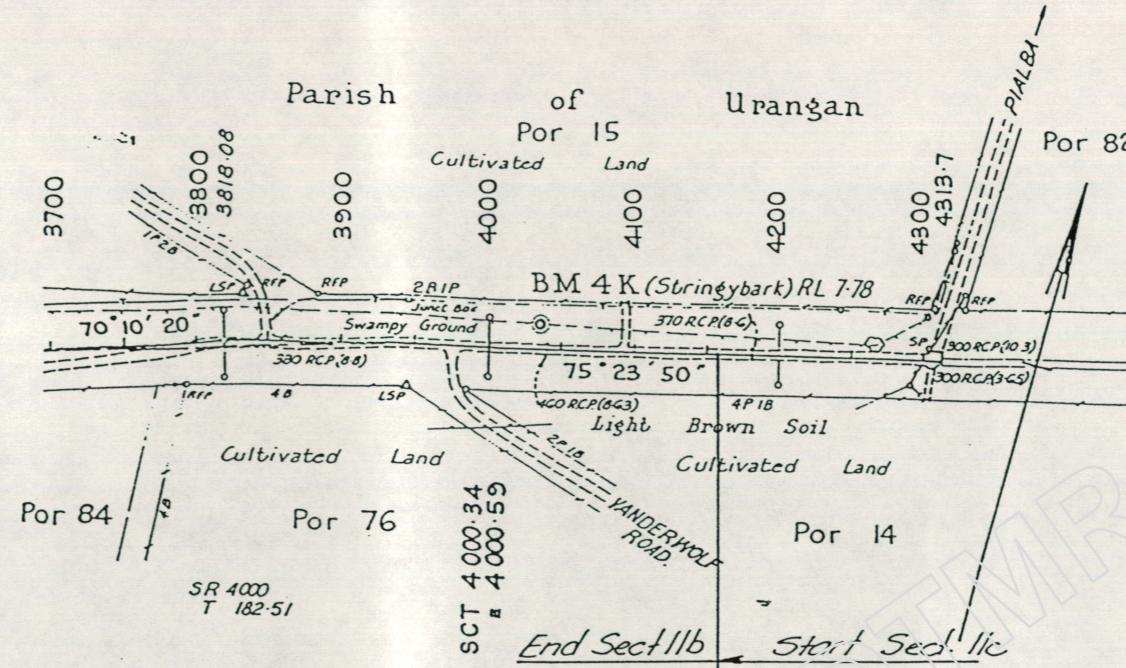


I certify that this is a
true and accurate copy of
the original drawing that has
been lost

NR

8/12/17

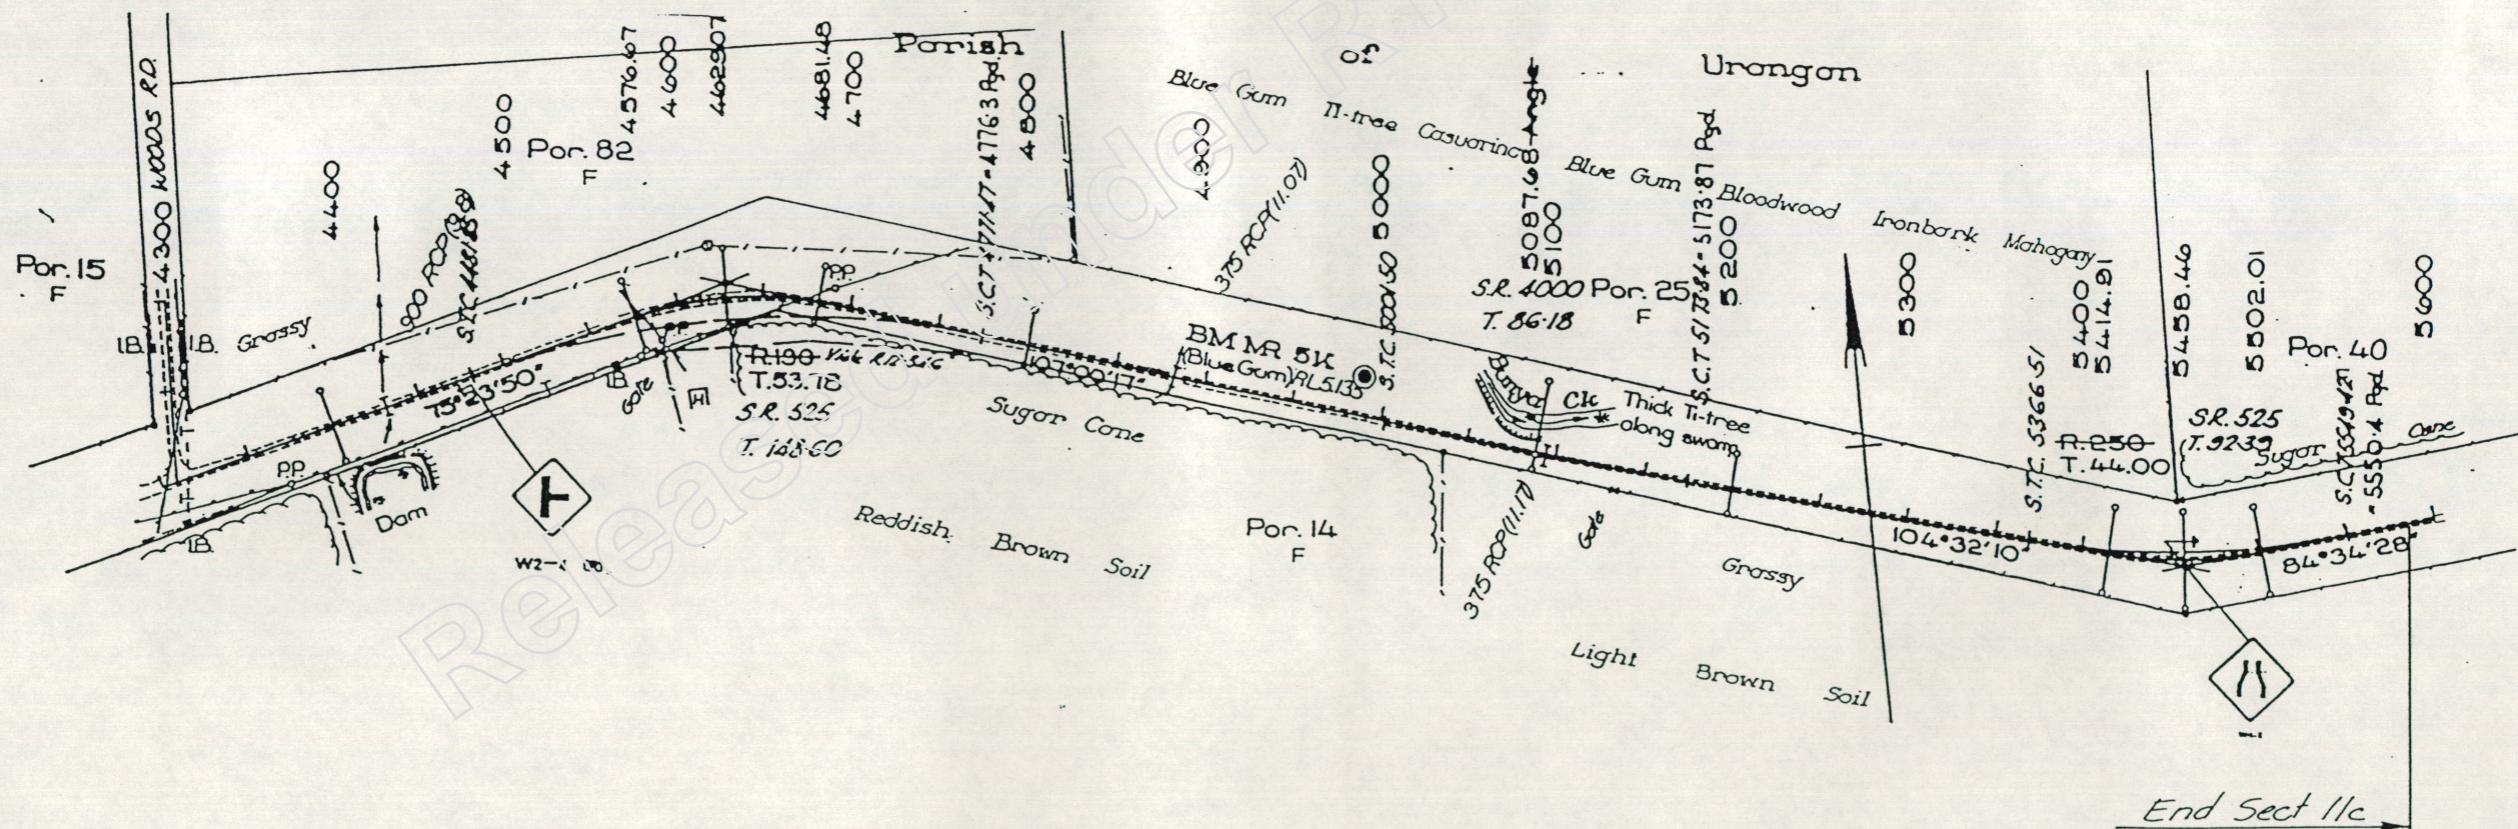

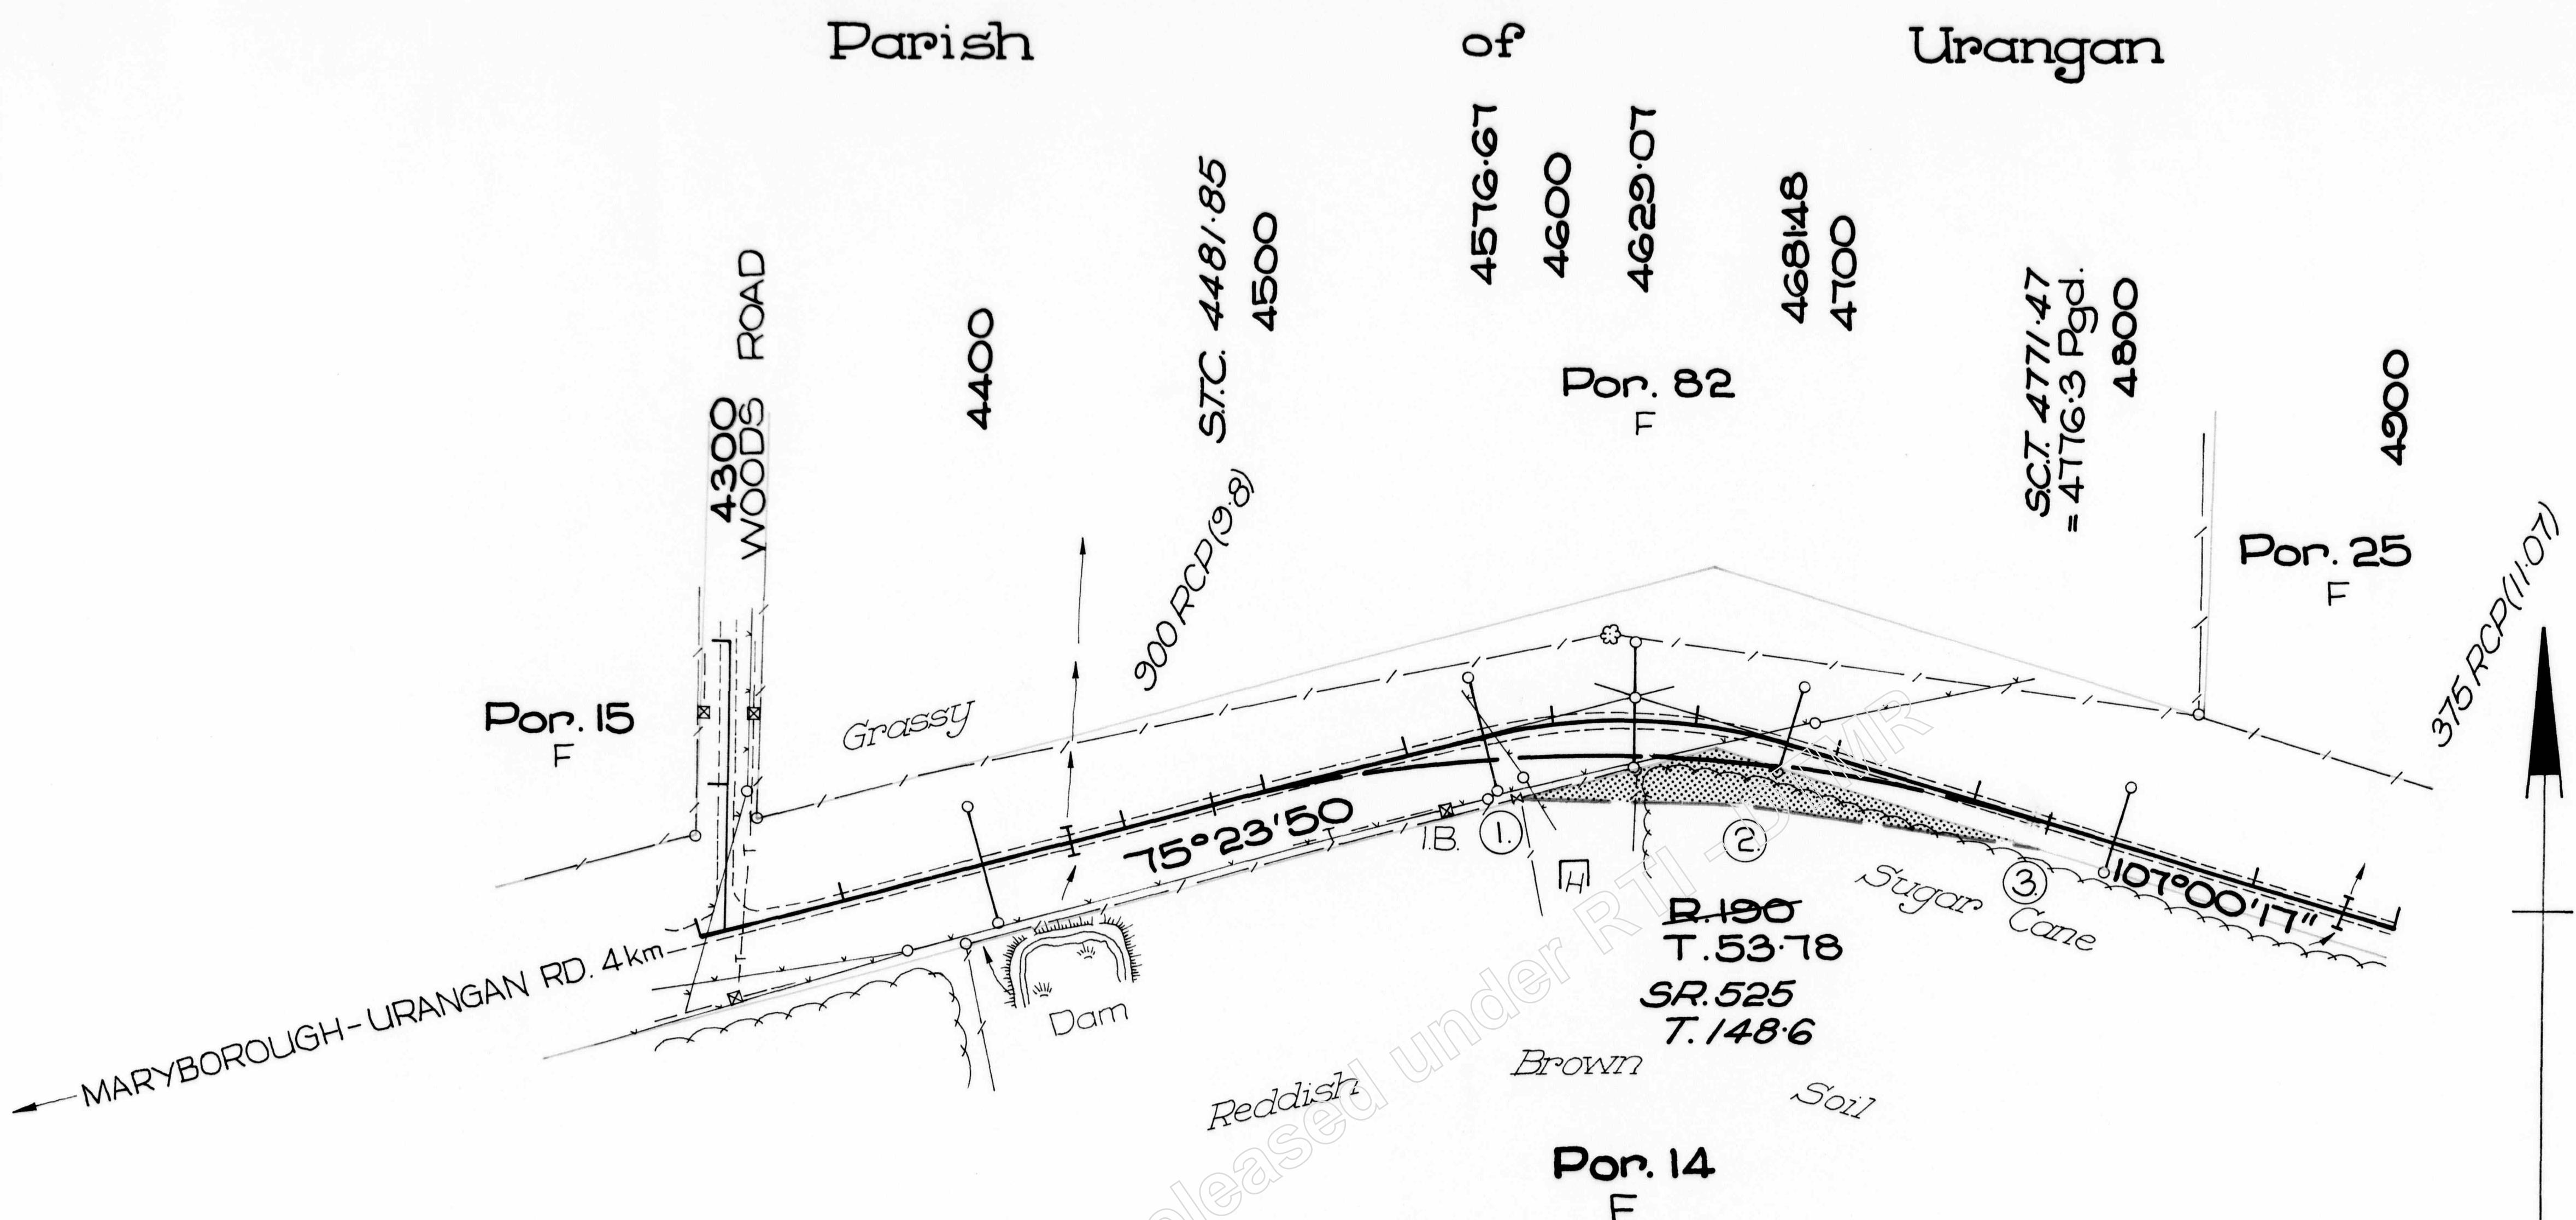

MRD Drawing No:
434072
MF 06.08A

Dist.(m) FROM PEGGED BASE LINE TO NEW BOUNDARY	
1.	On bdy. abt. 24m opp. 4583 approx.
2.	24m opp. 4672
3.	On bdy. abt. 10m opp. 4776.3

Length dimensions are given in metres. Areas are given in hectares (ha) or square metres (m²). 1 ha = 10 000 m².

OFFSET PEGS	CHAINAGE	DISTANCE(m)
	4400	20 L
	4576.67	20 R
	4629.07	27 L
	4681.48	16.5 R
	4800	20 L
		10 R

Revisions	Issue date	Micofiled	Dimension in metres except where shown otherwise	Property description	Plan showing area required from:- Por. 14	Drawn: AKP -6/86	MAIN ROADS DEPT.	HERVEY BAY CITY	AUTH. No.
			FULL SIZE A2 1:2000			Requirements: NR	BOORAL ROAD		24/1632/126
			0 20 40 60 80 m			Checked: -6/86	Aux. R. Plans:	Job No.: 24/1632/11	No. 1 OF 1 PLANS
							FLD. BK: 1632-21 W. PLANS: 104147	RECOMMENDED:	APPROVED: 24/6/86
							L.S. PLANS: M.37.49, M.3747, Mch.1568, M.37.48, M.37.214.	NR	NR
A	Original issue	5-7-86		Parish of Urangan County of March				Zer. 6/86	DISTRICT ENGINEER, DIST. 12 DIVISIONAL ENGINEER SEQ
									R12-346 A

Pages 33 through 86 redacted for the following reasons:

Exempt Sch.3(10)(1)(a) Prejudice an investigation

Released under RTI - DTMR

PARAMETERS:

Contract Office
 Claim Date Start 1-Jan-17
 Claim Date End 31-Jan-22
 Contract DC_16_17.12, DC_17_18, DC_18_19, DC_19_20, DC_20_21, DC_21_22

Schedules

Road Sections 1632
 Tdist_Start 4.8
 Tdist_End 5.4

WO Ref Num

Activities

Elements

Display Old Activ N

DATA:

Road Section	Status	Funding Element	TDist Start	TDist End	Fund	Schedule	Activity Type	Activity Description	Part	Sub Activity Type	Payment Method	Quantity	Claimed	Claim Start	Claim End	WO Ref Num
1632 C	15	0	18.393	2	3	105	Pothole Patching		0	-	U	\$ 1,027.33	22-Feb-17	24-Mar-17	2019590	
1632 C	15	0	18.393	2	3	105	Pothole Patching		0	-	U	\$ 179.73	25-Mar-17	20-Apr-17	2020513	
1632 C	15	0	18.393	2	3	105	Pothole Patching		0	-	U	\$ 565.90	21-Apr-17	24-May-17	2023624	
1632 C	15	0	18.393	2	3	105	Pothole Patching		0	-	U	\$ 700.96	25-May-17	23-Jun-17	2024803	
1632 C	15	0	18.393	2	3	105	Pothole Patching		0	-	U	\$ 1,258.27	24-Jun-17	30-Jun-17	2026944	
1632 C	15	0	18.393	2	3	401	Tractor Slashing, Rural		0	-	U	\$ 4,680.00	21-Apr-17	24-May-17	2023624	
1632 C	15	0	18.393	2	3	407	Herbicide Spraying		0	-	U	\$ 4,255.00	25-May-17	23-Jun-17	2024803	
1632 C	15	0	18.393	2	3	420	Roadside Litter Collection - Rural		0	P	F	\$ 76.01	24-Jan-17	21-Feb-17	2018502	
1632 C	15	0	18.393	2	3	420	Roadside Litter Collection - Rural		0	P	F	\$ 399.36	22-Feb-17	24-Mar-17	2019590	
1632 C	15	0	18.393	2	3	420	Roadside Litter Collection - Rural		0	P	F	\$ 1,241.91	25-Mar-17	20-Apr-17	2020513	
1632 C	15	0	18.393	2	3	420	Roadside Litter Collection - Rural		0	P	F	\$ 1,293.12	21-Apr-17	24-May-17	2023624	
1632 C	15	0	18.393	2	3	420	Roadside Litter Collection - Rural		0	P	F	\$ 930.00	24-Jun-17	30-Jun-17	2026944	
1632 C	15	0	18.393	2	3	512	Repair or Replace Guide Markers		0	P	F	\$ 137.64	22-Feb-17	24-Mar-17	2019590	
1632 C	15	0	18.393	2	3	512	Repair or Replace Guide Markers		0	P	F	\$ 580.57	25-Mar-17	20-Apr-17	2020513	
1632 C	15	0	18.393	2	3	519	Other Road Guide Post and Marker Wo<		0	P	F	\$ 76.01	24-Jan-17	21-Feb-17	2018502	
1632 C	15	0	18.393	2	3	519	Other Road Guide Post and Marker Wo<		0	P	F	\$ 598.12	22-Feb-17	24-Mar-17	2019590	
1632 C	15	0	18.393	2	3	519	Other Road Guide Post and Marker Wo<		0	P	F	\$ 342.83	25-Mar-17	20-Apr-17	2020513	
1632 C	15	0	18.393	2	3	519	Other Road Guide Post and Marker Wo<		0	P	F	\$ 373.08	21-Apr-17	24-May-17	2023624	
1632 C	15	0	18.393	2	3	519	Other Road Guide Post and Marker Wo<		0	P	F	\$ 93.71	24-Jun-17	30-Jun-17	2026944	
1632 C	15	0	18.393	2	3	903	Inspections for Forward List of Work		0	P	F	\$ 92.25	24-Jan-17	21-Feb-17	2018502	
1632 C	15	0	18.393	2	3	903	Inspections for Forward List of Work		0	P	F	\$ 92.25	22-Feb-17	24-Mar-17	2019590	
1632 C	15	0	18.393	2	3	903	Inspections for Forward List of Work		0	P	F	\$ 564.57	25-Mar-17	20-Apr-17	2020513	
1632 C	15	0	18.393	2	3	903	Inspections for Forward List of Work		0	P	F	\$ 630.38	21-Apr-17	24-May-17	2023624	
1632 C	15	0	18.393	2	3	903	Inspections for Forward List of Work		0	P	F	\$ 313.65	25-May-17	23-Jun-17	2024803	
1632 C	34	0	18.393	2	3	452	Emergency Call Out Activities		0	P	F	\$ 3,719.66	25-Mar-17	20-Apr-17	2020513	
1632 C	34	3.8	6.1	2	3	452	Emergency Call Out Activities		0	P	F	\$ 1,888.15	22-Feb-17	24-Mar-17	2019590	
1632 C	15	0	18.393	2	3	105	Pothole Patching		0	-	U	\$ 1,666.26	22-Feb-18	22-Mar-18	1159690	
1632 C	15	0	18.393	2	3	105	Pothole Patching		0	-	U	\$ 1,546.20	23-Mar-18	20-Apr-18	1168064	
1632 C	15	0	18.393	2	3	105	Pothole Patching		0	-	U	\$ 2,421.94	21-Apr-18	24-May-18	1175277	
1632 C	15	0	18.393	2	3	105	Pothole Patching		0	-	U	\$ 563.70	25-May-18	17-Jun-18	1184555	
1632 C	15	0	18.393	2	3	105	Pothole Patching		0	-	U	\$ 827.98	18-Jun-18	30-Jun-18	1191155	
1632 C	15	0	18.393	2	3	105	Pothole Patching		0	-	U	\$ 1,733.61	1-Jul-17	24-Jul-17	2031636	
1632 C	15	0	18.393	2	3	105	Pothole Patching		0	-	U	\$ 5,554.46	25-Jul-17	24-Aug-17	2032521	
1632 C	15	0	18.393	2	3	105	Pothole Patching		0	-	U	\$ 1,237.95	25-Aug-17	22-Sep-17	2032579	
1632 C	15	0	18.393	2	3	105	Pothole Patching		0	-	U	\$ 2,797.13	23-Sep-17	24-Oct-17	2041177	
1632 C	15	0	18.393	2	3	105	Pothole Patching		0	-	U	\$ 1,649.73	24-Nov-17	15-Dec-17	2048261	
1632 C	15	0	18.393	2	3	105	Pothole Patching		0	-	U	\$ 931.64	16-Dec-17	23-Jan-18	2051423	
1632 C	15	0	18.393	2	3	105	Pothole Patching		0	-	U	\$ 1,096.11	24-Jan-18	21-Feb-18	2056835	
1632 C	15	0	18.393	2	3	401	Tractor Slashing, Rural		0	-	U	\$ 4,770.00	25-May-18	17-Jun-18	1170129	
1632 C	15	0	18.393	2	3	401	Tractor Slashing, Rural		0	-	U	\$ 4,770.00	24-Jan-18	21-Feb-18	2051420	
1632 C	15	0	18.393	2	3	407	Herbicide Spraying		0	-	U	\$ 5,100.00	21-Apr-18	24-May-18	1173657	
1632 C	15	0	18.393	2	3	407	Herbicide Spraying		0	-	U	\$ 1,360.00	16-Dec-17	23-Jan-18	2048399	
1632 C	15	0	18.393	2	3	420	Roadside Litter Collection - Rural		0	P	F	\$ 613.29	22-Feb-18	22-Mar-18	1159689	
1632 C	15	0	18.393	2	3	420	Roadside Litter Collection - Rural		0	P	F	\$ 491.29	23-Mar-18	20-Apr-18	1168063	
1632 C	15	0	18.393	2	3	420	Roadside Litter Collection - Rural		0	P	F	\$ 232.51	21-Apr-18	24-May-18	1175276	
1632 C	15	0	18.393	2	3	420	Roadside Litter Collection - Rural		0	P	F	\$ 936.20	18-Jun-18	30-Jun-18	1191154	
1632 C	15	0	18.393	2	3	420	Roadside Litter Collection - Rural		0	P	F	\$ 818.52	1-Jul-17	24-Jul-17	2031637	
1632 C	15	0	18.393	2	3	420	Roadside Litter Collection - Rural		0	P	F	\$ 843.52	25-Jul-17	24-Aug-17	2032520	
1632 C	15	0	18.393	2	3	420	Roadside Litter Collection - Rural		0	P	F	\$ 424.19	25-Aug-17	22-Sep-17	2032580	
1632 C	15	0	18.393	2	3	420	Roadside Litter Collection - Rural		0	P	F	\$ 471.07	24-Nov-17	15-Dec-17	2048261	
1632 C	15	0	18.393	2	3	420	Roadside Litter Collection - Rural		0	P	F	\$ 1,610.05	16-Dec			

1632 C	15	0	18.393	2	3	512	Repair or Replace Guide Markers	0	P	F		\$ 1,066.84	25-Jul-17	24-Aug-17	2032519
1632 C	15	0	18.393	2	3	512	Repair or Replace Guide Markers	0	P	F		\$ 234.14	25-Aug-17	22-Sep-17	2032577
1632 C	15	0	18.393	2	3	512	Repair or Replace Guide Markers	0	P	F		\$ 926.09	24-Jan-18	21-Feb-18	2056835
1632 C	15	0	18.393	2	3	519	Other Road Guide Post and Marker Wo<	0	P	F		\$ 86.80	22-Feb-18	22-Mar-18	1159691
1632 C	15	0	18.393	2	3	519	Other Road Guide Post and Marker Wo<	0	P	F		\$ 85.58	21-Apr-18	24-May-18	1175278
1632 C	15	0	18.393	2	3	519	Other Road Guide Post and Marker Wo<	0	P	F		\$ 85.58	25-May-18	17-Jun-18	1184556
1632 C	15	0	18.393	2	3	519	Other Road Guide Post and Marker Wo<	0	P	F		\$ 172.02	18-Jun-18	30-Jun-18	1191156
1632 C	15	0	18.393	2	3	519	Other Road Guide Post and Marker Wo<	0	P	F		\$ 1,023.15	1-Jul-17	24-Jul-17	2031635
1632 C	15	0	18.393	2	3	519	Other Road Guide Post and Marker Wo<	0	P	F		\$ 1,320.20	25-Jul-17	24-Aug-17	2032522
1632 C	15	0	18.393	2	3	519	Other Road Guide Post and Marker Wo<	0	P	F		\$ 409.26	25-Aug-17	22-Sep-17	2032578
1632 C	15	0	18.393	2	3	519	Other Road Guide Post and Marker Wo<	0	P	F		\$ 166.87	25-Oct-17	23-Nov-17	2044205
1632 C	15	0	18.393	2	3	519	Other Road Guide Post and Marker Wo<	0	P	F		\$ 83.44	16-Dec-17	23-Jan-18	2051423
1632 C	15	0	18.393	2	3	519	Other Road Guide Post and Marker Wo<	0	P	F		\$ 910.67	24-Jan-18	21-Feb-18	2056835
1632 C	15	0	18.393	2	3	903	Inspections for Forward List of Work	0	P	F		\$ 81.25	22-Feb-18	22-Mar-18	1159688
1632 C	15	0	18.393	2	3	903	Inspections for Forward List of Work	0	P	F		\$ 820.82	23-Mar-18	20-Apr-18	1168062
1632 C	15	0	18.393	2	3	903	Inspections for Forward List of Work	0	P	F		\$ 761.83	21-Apr-18	24-May-18	1175275
1632 C	15	0	18.393	2	3	903	Inspections for Forward List of Work	0	P	F		\$ 344.04	25-May-18	17-Jun-18	1184553
1632 C	15	0	18.393	2	3	903	Inspections for Forward List of Work	0	P	F		\$ 892.83	18-Jun-18	30-Jun-18	1191153
1632 C	15	0	18.393	2	3	903	Inspections for Forward List of Work	0	P	F		\$ 45.32	1-Jul-17	24-Jul-17	2031639
1632 C	15	0	18.393	2	3	903	Inspections for Forward List of Work	0	P	F		\$ 90.65	25-Jul-17	24-Aug-17	2032518
1632 C	15	0	18.393	2	3	903	Inspections for Forward List of Work	0	P	F		\$ 90.65	25-Aug-17	22-Sep-17	2032581
1632 C	15	0	18.393	2	3	903	Inspections for Forward List of Work	0	P	F		\$ 883.02	23-Sep-17	24-Oct-17	2041177
1632 C	15	0	18.393	2	3	903	Inspections for Forward List of Work	0	P	F		\$ 453.23	25-Oct-17	23-Nov-17	2044205
1632 C	15	0	18.393	2	3	903	Inspections for Forward List of Work	0	P	F		\$ 135.97	24-Nov-17	15-Dec-17	2048261
1632 C	15	0	18.393	2	3	903	Inspections for Forward List of Work	0	P	F		\$ 345.99	16-Dec-17	23-Jan-18	2051423
1632 C	15	1.63	6	2	3	405	Clearing	0	P	F		\$ 4,352.59	22-Feb-18	22-Mar-18	1165906
1632 C	15	1.63	6	2	3	405	Clearing	0	P	F		-\$ 488.00	23-Mar-18	20-Apr-18	1170145
1632 C	15	4.745	4.98	2	3	146	Pavement Repairs, Asphalt (Mech. <500m	2	-	U		\$ 36,960.00	25-Oct-17	23-Nov-17	2042455
1632 C	15	0	18.393	2	3	105	Pothole Patching	0	-	U		\$ 1,681.79	1-Jul-18	24-Jul-18	1193804
1632 C	15	0	18.393	2	3	105	Pothole Patching	0	-	U		\$ 1,010.13	25-Jul-18	24-Aug-18	1199264
1632 C	15	0	18.393	2	3	105	Pothole Patching	0	-	U		\$ 1,059.75	25-Aug-18	21-Sep-18	1208662
1632 C	15	0	18.393	2	3	105	Pothole Patching	0	-	U		\$ 1,071.72	22-Sep-18	24-Oct-18	1218487
1632 C	15	0	18.393	2	3	105	Pothole Patching	0	-	U		\$ 483.92	25-Oct-18	23-Nov-18	1229537
1632 C	15	0	18.393	2	3	105	Pothole Patching	0	-	U		\$ 864.68	24-Nov-18	14-Dec-18	1238596
1632 C	15	0	18.393	2	3	105	Pothole Patching	0	-	U		\$ 1,397.31	15-Dec-18	23-Jan-19	1246763
1632 C	15	0	18.393	2	3	105	Pothole Patching	0	-	U		\$ 149.42	24-Jan-19	21-Feb-19	1251961
1632 C	15	0	18.393	2	3	105	Pothole Patching	0	-	U		\$ 578.50	22-Feb-19	22-Mar-19	1258894
1632 C	15	0	18.393	2	3	105	Pothole Patching	0	-	U		\$ 209.63	23-Mar-19	18-Apr-19	1268172
1632 C	15	0	18.393	2	3	105	Pothole Patching	0	-	U		\$ 634.96	19-Apr-19	22-May-19	1275842
1632 C	15	0	18.393	2	3	105	Pothole Patching	0	-	U		\$ 385.09	23-May-19	21-Jun-19	1283664
1632 C	15	0	18.393	2	3	105	Pothole Patching	0	-	U		\$ 842.49	22-Jun-19	30-Jun-19	1292056
1632 C	15	0	18.393	2	3	401	Tractor Slashing, Rural	0	-	U		\$ 4,770.00	25-Oct-18	23-Nov-18	1229753
1632 C	15	0	18.393	2	3	401	Tractor Slashing, Rural	0	-	U		\$ 4,770.00	23-May-19	21-Jun-19	1274529
1632 C	15	0	18.393	2	3	407	Herbicide Spraying	0	-	U		\$ 2,380.00	15-Dec-18	23-Jan-19	1229747
1632 C	15	0	18.393	2	3	407	Herbicide Spraying	0	-	U		\$ 1,190.00	24-Jan-19	21-Feb-19	1258022
1632 C	15	0	18.393	2	3	407	Herbicide Spraying	0	-	U		\$ 3,230.00	23-May-19	21-Jun-19	1274531
1632 C	15	0	18.393	2	3	420	Roadside Litter Collection - Rural	0	P	F		\$ 762.19	1-Jul-18	24-Jul-18	1193803
1632 C	15	0	18.393	2	3	420	Roadside Litter Collection - Rural	0	P	F		\$ 1,185.63	25-Jul-18	24-Aug-18	1199263
1632 C	15	0	18.393	2	3	420	Roadside Litter Collection - Rural	0	P	F		\$ 266.51	25-Aug-18	21-Sep-18	1208661
1632 C	15	0	18.393	2	3	420	Roadside Litter Collection - Rural	0	P	F		\$ 241.61	22-Sep-18	24-Oct-18	1218486
1632 C	15	0	18.393	2	3	420	Roadside Litter Collection - Rural	0	P	F		\$ 169.38	25-Oct-18	23-Nov-18	1229536
1632 C	15	0	18.393	2	3	420	Roadside Litter Collection - Rural	0	P	F		\$ 488.84	24-Nov-18	14-Dec-18	1238595
1632 C	15	0	18.393	2	3	420	Roadside Litter Collection - Rural	0	P	F		\$ 634.04	22-Feb-19	22-Mar-19	1258893
1632 C	15	0	18.393	2	3	420	Roadside Litter Collection - Rural	0	P	F		\$ 172.43	23-Mar-19	18-Apr-19	1268171
1632 C	15	0	18.393	2	3	420	Roadside Litter Collection - Rural	0	P	F		\$			

1632 C	15	0	18.393	2	3	519	Other Road Guide Post and Marker Wo<	0	P	F		\$ 243.82	19-Apr-19	22-May-19	1275840
1632 C	15	0	18.393	2	3	519	Other Road Guide Post and Marker Wo<	0	P	F		\$ 172.43	23-May-19	21-Jun-19	1283662
1632 C	15	0	18.393	2	3	903	Inspections for Forward List of Work	0	P	F		\$ 390.65	1-Jul-18	24-Jul-18	1193801
1632 C	15	0	18.393	2	3	903	Inspections for Forward List of Work	0	P	F		\$ 689.34	25-Jul-18	24-Aug-18	1199261
1632 C	15	0	18.393	2	3	903	Inspections for Forward List of Work	0	P	F		\$ 683.89	25-Aug-18	21-Sep-18	1208659
1632 C	15	0	18.393	2	3	903	Inspections for Forward List of Work	0	P	F		\$ 240.97	22-Sep-18	24-Oct-18	1218484
1632 C	15	0	18.393	2	3	903	Inspections for Forward List of Work	0	P	F		\$ 328.39	25-Oct-18	23-Nov-18	1229534
1632 C	15	0	18.393	2	3	903	Inspections for Forward List of Work	0	P	F		\$ 879.04	24-Nov-18	14-Dec-18	1238593
1632 C	15	0	18.393	2	3	903	Inspections for Forward List of Work	0	P	F		\$ 3,757.70	15-Dec-18	23-Jan-19	1246760
1632 C	15	0	18.393	2	3	903	Inspections for Forward List of Work	0	P	F		\$ 469.38	24-Jan-19	21-Feb-19	1251958
1632 C	15	0	18.393	2	3	903	Inspections for Forward List of Work	0	P	F		\$ 494.53	22-Feb-19	22-Mar-19	1258891
1632 C	15	0	18.393	2	3	903	Inspections for Forward List of Work	0	P	F		\$ 572.94	23-Mar-19	18-Apr-19	1268169
1632 C	15	0	18.393	2	3	903	Inspections for Forward List of Work	0	P	F		\$ 343.04	19-Apr-19	22-May-19	1275839
1632 C	15	0	18.393	2	3	903	Inspections for Forward List of Work	0	P	F		\$ 378.73	23-May-19	21-Jun-19	1283661
1632 C	15	5.36	5.44	2	3	153	Insitu Stabilisation-Minor (<500m2)	0	-	U		\$ 7,290.00	19-Apr-19	22-May-19	1019784
1632 C	34	0	18.393	2	4	450	Call Out	0	P	F		\$ 275.88	25-Jul-18	24-Aug-18	1207903
1632 C	15	0	18.393	2	3	105	Pothole Patching	0	-	U		\$ 1,681.79	1-Jul-18	24-Jul-18	1193804
1632 C	15	0	18.393	2	3	105	Pothole Patching	0	-	U		\$ 1,010.13	25-Jul-18	24-Aug-18	1199264
1632 C	15	0	18.393	2	3	105	Pothole Patching	0	-	U		\$ 1,059.75	25-Aug-18	21-Sep-18	1208662
1632 C	15	0	18.393	2	3	105	Pothole Patching	0	-	U		\$ 1,071.72	22-Sep-18	24-Oct-18	1218487
1632 C	15	0	18.393	2	3	105	Pothole Patching	0	-	U		\$ 483.92	25-Oct-18	23-Nov-18	1229537
1632 C	15	0	18.393	2	3	105	Pothole Patching	0	-	U		\$ 864.68	24-Nov-18	14-Dec-18	1238596
1632 C	15	0	18.393	2	3	105	Pothole Patching	0	-	U		\$ 1,397.31	15-Dec-18	23-Jan-19	1246763
1632 C	15	0	18.393	2	3	105	Pothole Patching	0	-	U		\$ 149.42	24-Jan-19	21-Feb-19	1251961
1632 C	15	0	18.393	2	3	105	Pothole Patching	0	-	U		\$ 578.50	22-Feb-19	22-Mar-19	1258894
1632 C	15	0	18.393	2	3	105	Pothole Patching	0	-	U		\$ 209.63	23-Mar-19	18-Apr-19	1268172
1632 C	15	0	18.393	2	3	105	Pothole Patching	0	-	U		\$ 634.96	19-Apr-19	22-May-19	1275842
1632 C	15	0	18.393	2	3	105	Pothole Patching	0	-	U		\$ 385.09	23-May-19	21-Jun-19	1283664
1632 C	15	0	18.393	2	3	105	Pothole Patching	0	-	U		\$ 842.49	22-Jun-19	30-Jun-19	1292056
1632 C	15	0	18.393	2	3	401	Tractor Slashing, Rural	0	-	U		\$ 4,770.00	25-Oct-18	23-Nov-18	1229753
1632 C	15	0	18.393	2	3	401	Tractor Slashing, Rural	0	-	U		\$ 4,770.00	23-May-19	21-Jun-19	1274529
1632 C	15	0	18.393	2	3	407	Herbicide Spraying	0	-	U		\$ 2,380.00	15-Dec-18	23-Jan-19	1229747
1632 C	15	0	18.393	2	3	407	Herbicide Spraying	0	-	U		\$ 1,190.00	24-Jan-19	21-Feb-19	1258022
1632 C	15	0	18.393	2	3	407	Herbicide Spraying	0	-	U		\$ 3,230.00	23-May-19	21-Jun-19	1274531
1632 C	15	0	18.393	2	3	420	Roadside Litter Collection - Rural	0	P	F		\$ 762.19	1-Jul-18	24-Jul-18	1193803
1632 C	15	0	18.393	2	3	420	Roadside Litter Collection - Rural	0	P	F		\$ 1,185.63	25-Jul-18	24-Aug-18	1199263
1632 C	15	0	18.393	2	3	420	Roadside Litter Collection - Rural	0	P	F		\$ 266.51	25-Aug-18	21-Sep-18	1208661
1632 C	15	0	18.393	2	3	420	Roadside Litter Collection - Rural	0	P	F		\$ 241.61	22-Sep-18	24-Oct-18	1218486
1632 C	15	0	18.393	2	3	420	Roadside Litter Collection - Rural	0	P	F		\$ 169.38	25-Oct-18	23-Nov-18	1229536
1632 C	15	0	18.393	2	3	420	Roadside Litter Collection - Rural	0	P	F		\$ 488.84	24-Nov-18	14-Dec-18	1238595
1632 C	15	0	18.393	2	3	420	Roadside Litter Collection - Rural	0	P	F		\$ 634.04	22-Feb-19	22-Mar-19	1258893
1632 C	15	0	18.393	2	3	420	Roadside Litter Collection - Rural	0	P	F		\$ 172.43	23-Mar-19	18-Apr-19	1268171
1632 C	15	0	18.393	2	3	420	Roadside Litter Collection - Rural	0	P	F		\$ 746.27	22-Jun-19	30-Jun-19	1292055
1632 C	15	0	18.393	2	3	512	Repair or Replace Guide Markers	0	P	F		\$ 113.98	1-Jul-18	24-Jul-18	1193805
1632 C	15	0	18.393	2	3	512	Repair or Replace Guide Markers	0	P	F		\$ 521.34	25-Jul-18	24-Aug-18	1199265
1632 C	15	0	18.393	2	3	512	Repair or Replace Guide Markers	0	P	F		\$ 257.26	25-Aug-18	21-Sep-18	1208663
1632 C	15	0	18.393	2	3	512	Repair or Replace Guide Markers	0	P	F		\$ 274.97	22-Sep-18	24-Oct-18	1218488
1632 C	15	0	18.393	2	3	512	Repair or Replace Guide Markers	0	P	F		\$ 100.73	24-Nov-18	14-Dec-18	1238597
1632 C	15	0	18.393	2	3	512	Repair or Replace Guide Markers	0	P	F		\$ 213.19	15-Dec-18	23-Jan-19	1246764
1632 C	15	0	18.393	2	3	512	Repair or Replace Guide Markers	0	P	F		\$ 375.22	24-Jan-19	21-Feb-19	1251962
1632 C	15	0	18.393	2	3	512	Repair or Replace Guide Markers	0	P	F		\$ 125.32	22-Feb-19	22-Mar-19	1258895
1632 C	15	0	18.393	2	3	512	Repair or Replace Guide Markers	0	P	F		\$ 121.91	19-Apr-19	22-May-19	1275843
1632 C	15	0	18.393	2	3	519	Other Road Guide Post and Marker Wo<	0	P	F		\$ 266.51	1-Jul-18	24-Jul-18	1193802
1632 C	15	0	18.393	2	3	519	Other Road Guide Post and Marker Wo<	0	P	F		\$ 749.74	25-Jul-18	24-Aug-18	1199262
1632 C	15	0	18.393	2	3	519	Other Road Guide Post and Marker Wo<	0	P	F		\$ 326			

1632 C	15	0	18.393	2	3	903	Inspections for Forward List of Work	0	P	F		\$ 343.04	19-Apr-19	22-May-19	1275839
1632 C	15	0	18.393	2	3	903	Inspections for Forward List of Work	0	P	F		\$ 378.73	23-May-19	21-Jun-19	1283661
1632 C	15	5.36	5.44	2	3	153	Insitu Stabilisation-Minor (<500m2)	0	-	U		\$ 7,290.00	19-Apr-19	22-May-19	1019784
1632 C	34	0	18.393	2	4	450	Call Out	0	P	F		\$ 275.88	25-Jul-18	24-Aug-18	1207903
1632 C	15	0	18.393	2	3	105	Pothole Patching	0	-	U		\$ 2,340.22	1-Jul-20	24-Jul-20	1407197
1632 C	15	0	18.393	2	3	105	Pothole Patching	0	-	U		\$ 2,096.89	25-Jul-20	24-Aug-20	1429002
1632 C	15	0	18.393	2	3	105	Pothole Patching	0	-	U		\$ 2,109.64	25-Aug-20	23-Sep-20	1434480
1632 C	15	0	18.393	2	3	105	Pothole Patching	0	-	U		\$ 232.72	24-Sep-20	23-Oct-20	1444135
1632 C	15	0	18.393	2	3	105	Pothole Patching	0	-	U		\$ 413.42	24-Oct-20	23-Nov-20	1457650
1632 C	15	0	18.393	2	3	105	Pothole Patching	0	-	U		\$ 1,768.25	24-Nov-20	11-Dec-20	1468687
1632 C	15	0	18.393	2	3	105	Pothole Patching	0	-	U		\$ 1,636.34	12-Dec-20	21-Jan-21	1468743
1632 C	15	0	18.393	2	3	105	Pothole Patching	0	-	U		\$ 396.28	20-Feb-21	24-Mar-21	1490040
1632 C	15	0	18.393	2	3	105	Pothole Patching	0	-	U		\$ 1,717.58	25-Mar-21	22-Apr-21	1504941
1632 C	15	0	18.393	2	3	105	Pothole Patching	0	-	U		\$ 919.53	23-Apr-21	21-May-21	1511202
1632 C	15	0	18.393	2	3	105	Pothole Patching	0	-	U		\$ 841.26	22-May-21	23-Jun-21	1519534
1632 C	15	0	18.393	2	3	105	Pothole Patching	0	-	U		\$ 164.89	24-Jun-21	30-Jun-21	1529104
1632 C	15	0	18.393	2	3	401	Tractor Slashing, Rural	0	-	U		\$ 4,860.00	1-Jul-20	24-Jul-20	1408851
1632 C	15	0	18.393	2	3	401	Tractor Slashing, Rural	0	-	U		\$ 4,860.00	22-Jan-21	19-Feb-21	1484728
1632 C	15	0	18.393	2	3	401	Tractor Slashing, Rural	0	-	U		\$ 4,860.00	23-Apr-21	21-May-21	1504770
1632 C	15	0	18.393	2	3	407	Herbicide Spraying	0	-	U		\$ 2,400.00	25-Aug-20	23-Sep-20	1435848
1632 C	15	0	18.393	2	3	407	Herbicide Spraying	0	-	U		\$ 4,500.00	12-Dec-20	21-Jan-21	1478302
1632 C	15	0	18.393	2	3	407	Herbicide Spraying	0	-	U		\$ 3,900.00	25-Mar-21	22-Apr-21	1504775
1632 C	15	0	18.393	2	3	420	Roadside Litter Collection - Rural	0	P	F		\$ 275.80	1-Jul-20	24-Jul-20	1407196
1632 C	15	0	18.393	2	3	420	Roadside Litter Collection - Rural	0	P	F		\$ 130.17	25-Jul-20	24-Aug-20	1429001
1632 C	15	0	18.393	2	3	420	Roadside Litter Collection - Rural	0	P	F		\$ 620.74	25-Aug-20	23-Sep-20	1434479
1632 C	15	0	18.393	2	3	420	Roadside Litter Collection - Rural	0	P	F		\$ 183.86	24-Sep-20	23-Oct-20	1444134
1632 C	15	0	18.393	2	3	420	Roadside Litter Collection - Rural	0	P	F		\$ 587.09	24-Nov-20	11-Dec-20	1468686
1632 C	15	0	18.393	2	3	420	Roadside Litter Collection - Rural	0	P	F		\$ 386.05	12-Dec-20	21-Jan-21	1468742
1632 C	15	0	18.393	2	3	420	Roadside Litter Collection - Rural	0	P	F		\$ 888.22	22-Jan-21	19-Feb-21	1482551
1632 C	15	0	18.393	2	3	420	Roadside Litter Collection - Rural	0	P	F		\$ 1,027.31	20-Feb-21	24-Mar-21	1490039
1632 C	15	0	18.393	2	3	420	Roadside Litter Collection - Rural	0	P	F		\$ 478.56	25-Mar-21	22-Apr-21	1504940
1632 C	15	0	18.393	2	3	420	Roadside Litter Collection - Rural	0	P	F		\$ 91.05	24-Jun-21	30-Jun-21	1529105
1632 C	15	0	18.393	2	3	512	Repair or Replace Guide Markers	0	P	F		\$ 117.50	1-Jul-20	24-Jul-20	1407195
1632 C	15	0	18.393	2	3	512	Repair or Replace Guide Markers	0	P	F		\$ 496.85	25-Jul-20	24-Aug-20	1429000
1632 C	15	0	18.393	2	3	512	Repair or Replace Guide Markers	0	P	F		\$ 328.44	25-Aug-20	23-Sep-20	1434478
1632 C	15	0	18.393	2	3	512	Repair or Replace Guide Markers	0	P	F		\$ 367.82	24-Oct-20	23-Nov-20	1457648
1632 C	15	0	18.393	2	3	512	Repair or Replace Guide Markers	0	P	F		\$ 156.34	24-Nov-20	11-Dec-20	1468685
1632 C	15	0	18.393	2	3	512	Repair or Replace Guide Markers	0	P	F	Bus/comm affairs	\$ 1,638.49	12-Dec-20	21-Jan-21	1468741
1632 C	15	0	18.393	2	3	512	Repair or Replace Guide Markers	0	P	F		\$ 475.12	22-Jan-21	19-Feb-21	1482550
1632 C	15	0	18.393	2	3	512	Repair or Replace Guide Markers	0	P	F		\$ 308.02	20-Feb-21	24-Mar-21	1490038
1632 C	15	0	18.393	2	3	512	Repair or Replace Guide Markers	0	P	F		\$ 277.73	25-Mar-21	22-Apr-21	1504939
1632 C	15	0	18.393	2	3	512	Repair or Replace Guide Markers	0	P	F		\$ 277.73	23-Apr-21	21-May-21	1511201
1632 C	15	0	18.393	2	3	519	Other Road Guide Post and Marker Wo<	0	P	F		\$ 211.53	1-Jul-20	24-Jul-20	1407194
1632 C	15	0	18.393	2	3	519	Other Road Guide Post and Marker Wo<	0	P	F		\$ 444.20	25-Jul-20	24-Aug-20	1428999
1632 C	15	0	18.393	2	3	519	Other Road Guide Post and Marker Wo<	0	P	F		\$ 551.60	25-Aug-20	23-Sep-20	1434477
1632 C	15	0	18.393	2	3	519	Other Road Guide Post and Marker Wo<	0	P	F		\$ 91.94	24-Sep-20	23-Oct-20	1444132
1632 C	15	0	18.393	2	3	519	Other Road Guide Post and Marker Wo<	0	P	F		\$ 331.78	24-Oct-20	23-Nov-20	1457647
1632 C	15	0	18.393	2	3	519	Other Road Guide Post and Marker Wo<	0	P	F		\$ 185.01	24-Nov-20	11-Dec-20	1468684
1632 C	15	0	18.393	2	3	519	Other Road Guide Post and Marker Wo<	0	P	F		\$ 745.18	12-Dec-20	21-Jan-21	1468740
1632 C	15	0	18.393	2	3	519	Other Road Guide Post and Marker Wo<	0	P	F		\$ 358.87	22-Jan-21	19-Feb-21	1482549
1632 C	15	0	18.393	2	3	519	Other Road Guide Post and Marker Wo<	0	P	F		\$ 663.47	20-Feb-21	24-Mar-21	1490037
1632 C	15	0	18.393	2	3	519	Other Road Guide Post and Marker Wo<	0	P	F		\$ 185.01	25-Mar-21	22-Apr-21	1504938
1632 C	15	0	18.393	2	3	519	Other Road Guide Post and Marker Wo<	0	P	F		\$ 315.75	23-Apr-21	21-May-21	1511199
1632 C	15	0	18.393	2	3	519	Other Road Guide Post and Marker Wo<	0	P	F		\$ 408.25	22-May-21	23-Jun-21	1519531
1632 C	15	0	18.393	2	3	519	Other Road Guide Post and Marker Wo<	0	P						

1632 C	15	0	18.393	2	3	407	Herbicide Spraying	0	P	F		\$ 3,440.79	24-Sep-21	22-Oct-21	1566799
1632 C	15	0	18.393	2	3	420	Roadside Litter Collection - Rural	0	P	F		\$ 469.96	1-Jul-21	23-Jul-21	1526201
1632 C	15	0	18.393	2	3	420	Roadside Litter Collection - Rural	0	P	F		\$ 618.43	24-Sep-21	22-Oct-21	1565237
1632 C	15	0	18.393	2	3	420	Roadside Litter Collection - Rural	0	P	F		\$ 993.35	23-Oct-21	23-Nov-21	1576625
1632 C	15	0	18.393	2	3	420	Roadside Litter Collection - Rural	0	P	F		\$ 94.68	24-Nov-21	17-Dec-21	1587782
1632 C	15	0	18.393	2	3	512	Repair or Replace Guide Markers	0	P	F		\$ 327.87	1-Jul-21	23-Jul-21	1526202
1632 C	15	0	18.393	2	3	512	Repair or Replace Guide Markers	0	P	F		\$ 162.87	24-Jul-21	24-Aug-21	1541280
1632 C	15	0	18.393	2	3	512	Repair or Replace Guide Markers	0	P	F		\$ 403.51	24-Sep-21	22-Oct-21	1565238
1632 C	15	0	18.393	2	3	512	Repair or Replace Guide Markers	0	P	F		\$ 190.82	24-Nov-21	17-Dec-21	1587783
1632 C	15	0	18.393	2	3	512	Repair or Replace Guide Markers	0	P	F		\$ 472.70	18-Dec-21	19-Jan-22	1597532
1632 C	15	0	18.393	2	3	519	Other Road Guide Post and Marker Wo<	0	P	F		\$ 182.11	1-Jul-21	23-Jul-21	1526199
1632 C	15	0	18.393	2	3	519	Other Road Guide Post and Marker Wo<	0	P	F		\$ 382.54	25-Aug-21	23-Sep-21	1554793
1632 C	15	0	18.393	2	3	519	Other Road Guide Post and Marker Wo<	0	P	F		\$ 474.32	24-Sep-21	22-Oct-21	1565235
1632 C	15	0	18.393	2	3	519	Other Road Guide Post and Marker Wo<	0	P	F		\$ 926.19	23-Oct-21	23-Nov-21	1576623
1632 C	15	0	18.393	2	3	519	Other Road Guide Post and Marker Wo<	0	P	F		\$ 189.37	24-Nov-21	17-Dec-21	1587780
1632 C	15	0	18.393	2	3	519	Other Road Guide Post and Marker Wo<	0	P	F		\$ 188.22	18-Dec-21	19-Jan-22	1597529
1632 C	15	0	18.393	2	3	903	Inspections for Forward List of Work	0	P	F		\$ 557.06	1-Jul-21	23-Jul-21	1526203
1632 C	15	0	18.393	2	3	903	Inspections for Forward List of Work	0	P	F		\$ 333.20	24-Jul-21	24-Aug-21	1541281
1632 C	15	0	18.393	2	3	903	Inspections for Forward List of Work	0	P	F		\$ 476.50	25-Aug-21	23-Sep-21	1554797
1632 C	15	0	18.393	2	3	903	Inspections for Forward List of Work	0	P	F		\$ 339.09	24-Sep-21	22-Oct-21	1565239
1632 C	15	0	18.393	2	3	903	Inspections for Forward List of Work	0	P	F		\$ 925.65	23-Oct-21	23-Nov-21	1576627
1632 C	15	0	18.393	2	3	903	Inspections for Forward List of Work	0	P	F		\$ 308.55	24-Nov-21	17-Dec-21	1587784
1632 C	15	0	18.393	2	3	903	Inspections for Forward List of Work	0	P	F		\$ 777.86	18-Dec-21	19-Jan-22	1597533
1632 C	56	5.073	5.123	2	4	450	Call Out	0	P	F		\$ 2,289.77	18-Dec-21	19-Jan-22	1602827

Released under RTI - DTMR